


SUMMARY OF QUANTITIES				
ITEM NO.	ITEM	UNIT	QUANTITY	AS-BUILT
EROSION AND SEDIMENT CONTROL				
1	SWPPP DOCUMENTATION AND MANAGEMENT	L.SUM	1	
2	TEMPORARY CONSTRUCTION ENTRANCE	EA.	2	
3	SILT FENCE	L.F.	2200	
4	TEMPORARY SEEDING	AC	4.65	
5	CURB INLET FILTER AMT SEDIMENT BARRIER	EA.	5	
DEMOLITION				
6	CLEARING AND GRUBBING	L.SUM	1	
7	ASPHALT REMOVAL	S.Y.	3748	
8	CHAIN LINK SECURITY FENCE AND GATE REMOVAL	L.F.	530	
EARTHWORK				
9	UNCLASSIFIED EXCAVATION	C.Y.	2160	
10	EMBANKMENT	C.Y.	1400	
11	BEDDING MATERIAL	C.Y.	2500	
12	TYPE A TOPSOIL	L.SUM	1	
13	SLAB SOD	S.Y.	8900	
PAVEMENT				
14	P.C. CONCRETE	C.Y.	625	
15	REINFORCING STEEL	LB.	32910	
16	ASPHALT	TON	410	
STORM DRAINAGE				
17	PRECAST 4'X4' REINFORCED CONCRETE BOX	L.F.	1216	
18	12'X4' PRECAST REINFORCED CONCRETE JUNCTION BOX W/4'X4' RISER	EA.	1	
19	6'X6' PRECAST REINFORCED CONCRETE JUNCTION BOX W/4' DIA. RISER	EA.	1	
20	4'X4' PRECAST REINFORCED CONCRETE JUNCTION BOX W/4'X4' RISER	EA.	4	
21	PRECAST REINFORCED CONCRETE CATCH BASIN W/2 GRATES	EA.	2	
22	5' DIA MANHOLE	EA.	2	
23	18" REINFORCED CONCRETE PIPE	L.F.	6	
24	24" REINFORCED CONCRETE PIPE	L.F.	176	
25	36" REINFORCED CONCRETE PIPE	L.F.	637	
26	48" REINFORCED CONCRETE PIPE	L.F.	30	
27	36" PRECAST CONCRETE END SECTION	EA.	1	
28	CONCRETE END TREATMENT (4-24" RCP)	EA.	1	
29	RELOCATE/ADJUST UTILITIES	L.SUM	1	
30	CONSTRUCTION TRAFFIC CONTROL	L.SUM	1	
31	(PL) TRAFFIC ITEMS	L.SUM	1	
32	PORTABLE LONGITUDINAL BARRIER	L.F.	900	

GENERAL CONSTRUCTION NOTES

- ALL CIVIL SITE CONSTRUCTION SHALL BE IN ACCORDANCE WITH THE CITY OF OKLAHOMA CITY STANDARD SPECIFICATIONS FOR CONSTRUCTION, CURRENT EDITION, UNLESS OTHERWISE SPECIFIED OR AS SHOWN ON THE PLANS. ODOT STANDARDS SHALL BE USED WHEN CITY OF OKLAHOMA CITY STANDARDS ARE NOT APPLICABLE.
- THE CONTRACTOR SHALL GIVE NOTICE TO THE CITY, IN WRITING, FOURTEEN (14) DAYS BEFORE WORK ON THIS PROJECT BEGINS.
- NO PAYMENT WILL BE MADE FOR THE REMOVAL OF ABANDONED UTILITY PIPE LINES THAT INTERFERE WITH CONSTRUCTION. ALL COST TO BE INCLUDED IN OTHER ITEMS OF WORK.
- ALL WORK AND/OR MATERIALS NOT CLASSIFIED AS A "CONTRACT PAY ITEM" SHALL BE CONSIDERED INCIDENTAL AND THE COST THEREOF SHALL BE INCLUDED IN THE UNIT PRICE BID FOR ITEMS WHICH ARE CLASSIFIED FOR PAYMENT.
- THE CONTRACTOR SHALL SEAL ANY CRACK THAT DEVELOPS IN THE PAVEMENT SURFACE PRIOR TO FINAL INSPECTION. COST TO BE INCLUDED IN OTHER ITEMS OF WORK.
- TREES OUTSIDE THE TOE OF FILL SLOPES AND THE TOP OF CUT SLOPES SHALL NOT BE DISTURBED EXCEPT WITH THE APPROVAL OF THE ENGINEER.
- (CAUTION) THE LOCATION AND DEPTH OF ALL UTILITIES AS SHOWN ON THE PLANS ARE APPROXIMATE AND SHALL BE FIELD VERIFIED BY THE CONTRACTOR PRIOR TO CONSTRUCTION.
- THE CONTRACTOR SHALL BE RESPONSIBLE FOR ANY DAMAGE HE MAY INFLICT TO THE EXISTING UNDERGROUND UTILITIES WITHIN THE PROJECT AREA AS A RESULT OF HIS DIGGING, TRENCHING, BORING, ETC. PRIOR TO DIGGING NEAR THE UTILITIES, THE CONTRACTOR SHALL CALL FOR A LIST OF ALL UNDERGROUND FACILITIES REGISTERED WITH THE FOLLOWING AGENCIES:
THE LOCAL COUNTY CLERK'S OFFICE
THE LOCAL CITY GOVERNMENT'S OFFICE
THE "CALL OKIE" NOTIFICATION CENTER: (405) 840-5032 OR (800) 522-6543
- THE CONTRACTOR SHALL BE RESPONSIBLE FOR ANY DAMAGE HE MAY INFLICT TO THE EXISTING DRAINAGE STRUCTURES TO REMAIN IN PLACE, AND SHALL REPAIR SUCH DAMAGES AT NO ADDITIONAL COST TO THE OWNER.
- ALL MATERIAL REMOVED, INCLUDING BUT NOT LIMITED TO DRAINAGE STRUCTURES, SHALL BECOME THE PROPERTY OF THE CONTRACTOR AND SHALL BE DISPOSED OF IN A MANNER APPROVED BY THE ENGINEER, UNLESS OTHERWISE SPECIFIED.
- FILL AREA TO BE COMPACTED TO 95% PROCTOR DENSITY IN LIFTS NOT TO EXCEED 1 FOOT.
- RCP WITH "O" RINGS, HDPE PIPES AND PVC PIPES WITH "GASKETS" SHALL BE INSTALLED UNDER STREETS AND ROADWAYS, NEXT TO CURBS, UNDER DETENTION POND EMBANKMENTS, AND BETWEEN HOUSES. ALL JOINTS ON RCP, HDPE PIPE, AND PVC SHALL BE WRAPPED WITH TWO FEET WIDE FILTER FABRIC STRIP AROUND THE JOINT AND OVERLAPPING TWO FEET.
- COMPACTION OF TRENCH BACKFILL IN PAVED AREAS SHALL BE A MINIMUM OF 95% STANDARD PROCTOR DENSITY.
- THE CONTRACTOR SHALL BE RESPONSIBLE FOR REPLACING ALL LANDSCAPING IN AS GOOD OR BETTER CONDITION THAN EXISTING LANDSCAPING.
- THE CONTRACTOR SHALL FIELD VERIFY ALL EXISTING UTILITIES PRIOR TO CONSTRUCTION.
- THE CONTRACTOR SHALL BE RESPONSIBLE FOR THE PLACEMENT OR REPAIR OF ALL PRIVATE AND PUBLIC UTILITIES DAMAGED DURING CONSTRUCTION.
- THE CONTRACTOR SHALL BE RESPONSIBLE FOR GRADING ALL DISTURBED AREAS TO DRAIN AS GOOD OR BETTER THAN EXISTING CONDITIONS.
- ALL P.C. CONCRETE PAVEMENT, CURBS, DRIVEWAYS AND SIDEWALKS DISTURBED BY THE PROJECT SHALL BE REPLACED WITH HIGH EARLY STRENGTH (HES) CONCRETE, 3500 PSI MIN.
- TYPE A SALVAGED TOPSOIL PER ODOT STANDARDS AND SPECIFICATIONS.
- RELOCATE/ADJUST UTILITIES SHALL INCLUDE, BUT NOT LIMITED TO, ELECTRIC, FIBER OPTIC, TELEPHONE AND CABLE TELEVISION LINES.
- BEDDING MATERIAL IS MEASURED BY O.D.O.T. STANDARD PIPE BEDDING. INCLUDES 6" OF STD. BEDDING MATERIAL TO BE USED IN THE INSTALLATION OF THE 4'x4' RCB.
- TACK COAT IS INCLUDED IN THE PRICE BID FOR ASPHALT.
- STRUCTURAL EXCAVATION IS INCLUDED IN THE PRICE BID FOR UNCLASSIFIED EXCAVATION.

PROJECT NO. DD-0782

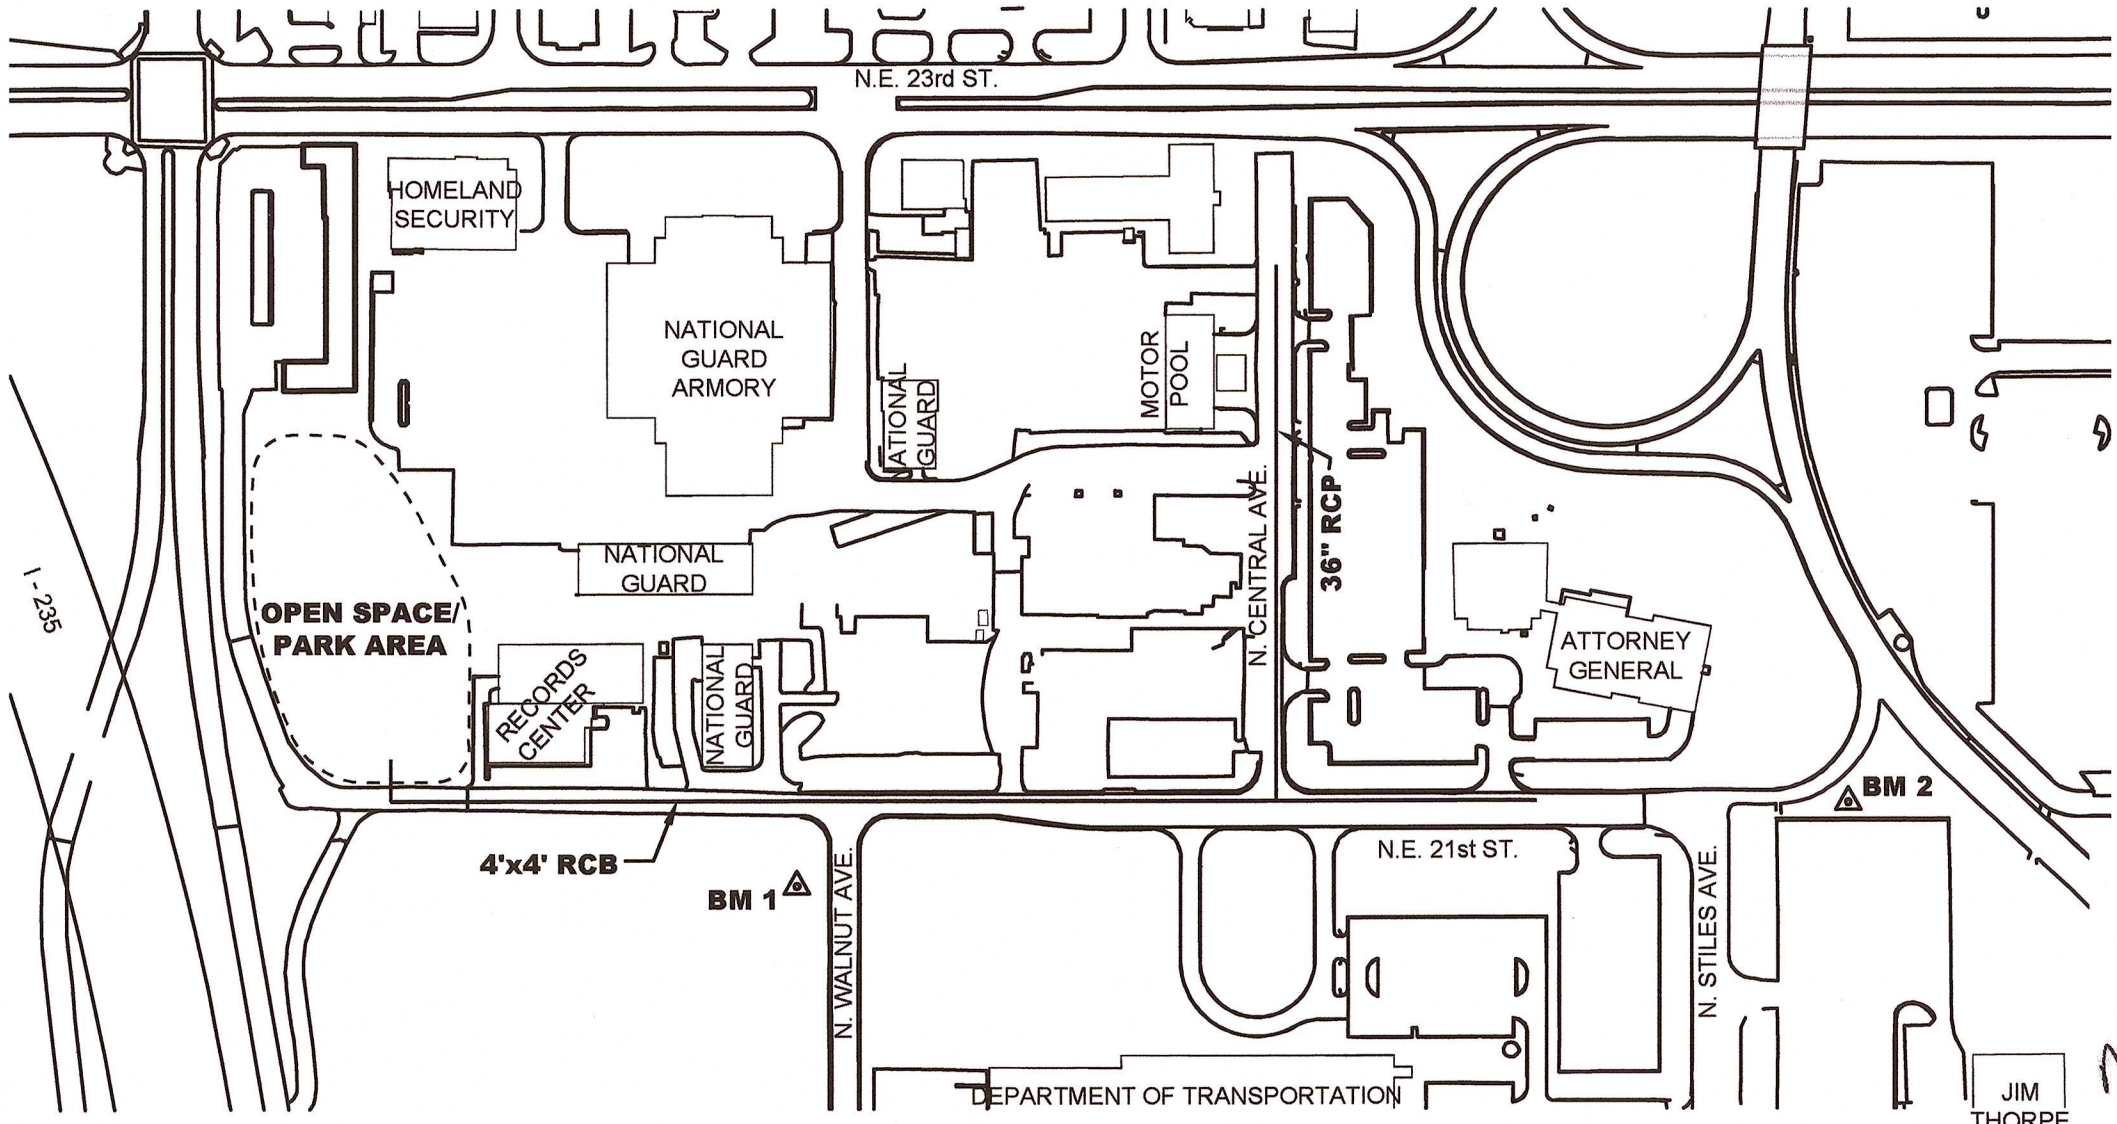

DRAINAGE IMPROVEMENT PLANS
STATE CAPITOL COMPLEX
N.E. 21st STREET, OKLAHOMA CITY, OKLAHOMA

SURVEY CONTROL				
POINT #	NORTHING	EASTING	ELEVATION	DESCRIPTION
BM1	179076.97	2114686.07	1216.08	5/8" CAPPED I.P.
BM2	179165.26	2115784.00	1234.10	5/8" CAPPED I.P.
SC02	181590.33	2115263.46	1213.33	1/2" CAPPED I.P.
SC03	178222.49	2115140.77	1236.45	1/2" CAPPED I.P.
GRANDYS	184976.64	2116359.08	1195.31	1/2" CAPPED I.P.
421NE13	175975.97	2115968.14	1267.88	1/2" CAPPED I.P.

RECORD DRAWINGS
ORIGINAL DRAWINGS WAS SIGNED AND SEALED
BY REZA KHAKPOUR P.E.,CFM 19959 DATED 8-28-2012.
DRAWINGS REVISIONS WERE SIGNED AND SEALED BY
MICHAEL JUDD P.E. DATED 11-19-2013.

TO THE BEST KNOWLEDGE OF THE ENGINEER, THESE
DRAWINGS HAVE BEEN CONFORMED TO THE ACTUAL
CONSTRUCTION OF THE IMPROVEMENTS BASED ON
INFORMATION SUPPLIED BY THE OWNER, CONTRACTOR,
AND RESIDENT PROJECT REPRESENTATIVE.

Michael R. Judd 1/23/2015
MICHAEL R. JUDD (12260) DATE

CONTRACTOR NOTES

- CONTRACTOR SHALL GIVE LEIDOS (SAIC) ENGINEERING AT LEAST 48 HR'S PRIOR NOTICE TO ANY MAJOR CONSTRUCTION PHASES. PHASES WILL BE DECIDED / DISCUSSED AT THE PRE-WORK CONFERENCE. CONTRACTOR SHALL ALLOW LEIDOS (SAIC) ENGINEERING, LLC AT LEAST 7 DAYS FOR APPROVAL OF SHOP DRAWINGS, TESTING OF MATERIALS, ETC PRIOR TO CONSTRUCTION. LEIDOS, (SAIC) ENGINEERING, LLC HAS AUTHORITY TO STOP WORK IN CASE OF A FAILED TEST.

EROSION CONTROL NOTES

- THE CONTRACTOR SHALL INSTALL ALL THE EROSION CONTROL DEVICES.
- THE CONTRACTOR SHALL BE RESPONSIBLE FOR THE REPAIR OR REPLACEMENT OF ALL EROSION CONTROL DEVICES DAMAGED DUE TO CONSTRUCTION.
- A COPY OF THE EROSION CONTROL SITE PLAN MUST BE ON SITE AT ALL TIMES AND MADE AVAILABLE TO THE INSPECTOR UPON REQUEST.
- CONSTRUCTION ACTIVITIES THAT RESULT IN LAND DISTURBANCE OF EQUAL TO OR GREATER THAN ONE (1) ACRE, OR LESS THAN ONE (1) ACRE IF THEY ARE PART OF A LARGER COMMON PLAN OF DEVELOPMENT OR SALE THAT TOTALS AT LEAST ONE (1) ACRE MUST ALSO OBTAIN A PERMIT FROM ODEQ (FORM 605-002a) FOR STORM WATER DISCHARGE FROM CONSTRUCTION ACTIVITIES.


UTILITY COMPANY CONTACTS			
UTILITY	COMPANY	CONTACT	PHONE NUMBER
CABLE TV	COX COMMUNICATIONS	MARK BOWLING	405-417-4064
COMMUNICATIONS	AT&T	LEE MARSH	405-291-3169
FIBER OPTICS	STATE OF OKLAHOMA	ALLEN STEVENSON	405-521-6460
FIBER OPTICS	MCI/VERIZON	RYAN ROBERTS	580-579-0735
* FIBER OPTICS	OKLAHOMA STATE FINANCE	RALPH SMITH	405-521-3901
ELECTRIC	OG&E	SHAUN MCALISTER	405-919-6160
NATURAL GAS	ONG	TOMMY BROWN	405-556-6411
WATER	OKC LINE MAINTENANCE	ALLEN TOTTEN	405-297-2066

* CONTACT RALPH SMITH PRIOR TO COMMENCEMENT OF UTILITY RELOCATION.



DESCRIPTION	REVISION	DATE
ADDED 18" RCP AND CONTRACTOR NOTE	1	11/04/13

The City of
OKLAHOMA CITY
Public Works Department

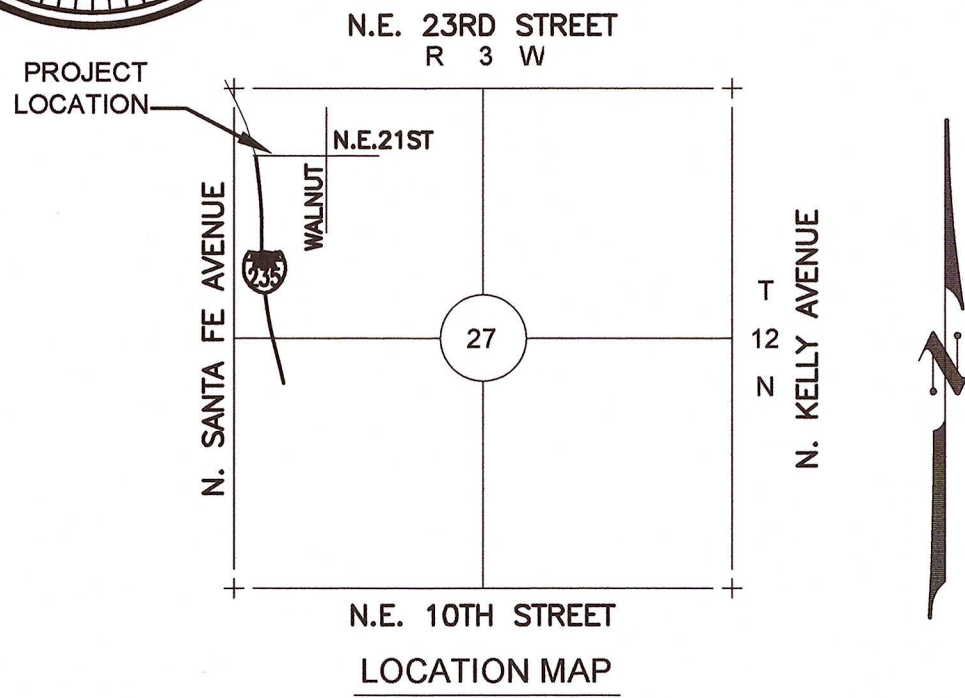

SHEET NO.	DESCRIPTION
G-001	COVER SHEET
G-002	ABBREVIATIONS AND SURVEY LEGEND
VF101	EXISTING SITE CONDITIONS 1
VF102	EXISTING SITE CONDITIONS 2
CD101	DEMOLITION PLAN 1
CD102	DEMOLITION PLAN 2
CE101	EROSION CONTROL PLAN
CE801	STORM WATER MANAGEMENT PLAN
CG201	STORM DRAIN LINE 1, 2A & 2B PLAN AND PROFILE
CG202	STORM DRAIN LINE 1 PLAN AND PROFILE
CG203	STORM DRAIN LINE 3 PLAN AND PROFILE
CT001	TRAFFIC CONTROL NOTES
CT101	CONSTRUCTION TRAFFIC CONTROL - PHASE 1
CT102	CONSTRUCTION TRAFFIC CONTROL - PHASE 1
CT103	CONSTRUCTION TRAFFIC CONTROL - PHASE 2
CT104	CONSTRUCTION TRAFFIC CONTROL - PHASE 2
CT105	CONSTRUCTION TRAFFIC CONTROL - PHASE 3
CT106	CONSTRUCTION TRAFFIC CONTROL - PHASE 3
CT107	CONSTRUCTION TRAFFIC CONTROL - SIGN DETAILS
CT108	CONSTRUCTION TRAFFIC CONTROL - STRIPING
ERO-D1	OKC EROSION CONTROL STANDARDS
ERO-D2	OKC EROSION CONTROL STANDARDS
D-010	OKC STORM WATER EROSION AND SEDIMENT CONTROL PROCEDURES
D-102	OKC GRATED STREET INLET DETAIL
D-201	OKC STANDARD MASONRY MANHOLE
D-203	OKC STANDARD REINFORCED CONCRETE JUNCTION BOX FOR 36" TO 72" REINFORCED CONCRETE PIPE
D-301	OKC STANDARD RFCB-1C-B
D-408	OKC STANDARD PREFABRICATED CULVERT SECTIONS
CET4D-3	ODOT CULVERT END TREATMENT
SPI-4	ODOT STANDARD PIPE INSTALLATION
SPB-1	ODOT STANDARD PIPE BEDDING
FHTCP-3	ODOT FILL HEIGHT TABLES
SBI-4	ODOT STANDARD BOX INSTALLATION

ONE CALL UTILITY LOCATION NUMBER	
840-5032 1-800-522-6543	This number is to be used for information on the location of underground utilities. Contact this number and other numbers in the plans prior to any excavation.
SAIC From Science to Solutions SAIC ENERGY, ENVIRONMENT & INFRASTRUCTURE, LLC 9400 N BROADWAY OKLAHOMA CITY, OK 73114 405-478-5353 www.saic.com CERT. OF AUTH. NO. 3722 P.E./L.S. EXP. 06/30/14	SUBMITTAL DATES TO OKC Check Print #1 Date: Check Print #2 Date: Final Plans Date: CONSTRUCTION MUST BEGIN WITHIN ONE (1) YEAR FROM THE DATE OF APPROVAL, OR THAT APPROVAL IS WITHDRAWN.
PREPARED BY: <i>M. Reza Khakpour</i> M. REZA KHAKPOUR, P.E.	DEPARTMENT OF PUBLIC WORKS ENGINEERING DIVISION
REGISTERED PROFESSIONAL ENGINEER OK #19959, EXPIRES 5/31/2014	Field Checked by: Date:
	Checked by: Date:
	Checked by: Date:
	Checked by: Date:
	APPROVED:
	City Engineer Date:
STATE CAPITOL COMPLEX	SHEET G-001 PROJECT NO. DD-0782

ABBREVIATIONS

A	ABAN. ABUT. ACC. AC. ADD'L. ADJ. ADT AE AGGR. A.I. AHD. ALT. ALUMN. APPR. APPL. APPROX. APR. ASB. ASPH. ASP. AVE. AVG. AZ.	ABANDONED ABUTMENT ACCESS ACRE ADDITIONAL ADJUST AVERAGE DAILY TRAFFIC AIR—ENTRAINED AGGREGATE AREA INLET AHEAD ALTERNATE ALUMINUM APPROACH APPLICATION APPROXIMATE APRON ASBESTOS ASPHALT ASPHALT AVENUE AVERAGE AZIMUT
B	BL BAL. BBL. BDY. BEG. BIT. BK. BKWL. BLDG. BLK. BLVD. B.M. B.O.P. BRG. B.S. B.W.	BLOCK LINE; BASE LINE BALANCE BARREL BOUNDARY BEGIN BITUMINOUS BACK BACKWALL BUILDING BLOCK BOULEVARD BENCH MARK BEGINNING OF PROJECT BEARING BACK SIGHT BARBED WIRE
C	C. CL CGMP CGMPA C & G CIP CL. CLR. CMP CO. CONC. CONST. CONTR. COORD. COR. CORP. C.R.L. CU. CULT. CULV.	CENTER CENTERLINE CORRUGATED GALVANIZED METAL PIPE CORRUGATED GALVANIZED METAL PIPE ARCH CURB & GUTTER CAST IRON PIPE CLASS CLEAR CORRUGATED METAL PIPE COUNTY CONCRETE CONSTRUCT CONTRACTOR COORDINATE CORNER CORPORATE; CORPORATION CONSTRUCTION REFERENCE LINE CUBIC CULTIVATED CULVERT
D	D D.A. DBL. DEMO. D.I. DIA. DIFF. DIM. DIP DIST. DR. DWL.	DEGREE OF CURVE DRAINAGE AREA DOUBLE DEMOLISH / DEMOLITION DROP INLET DIAMETER DIFFERENCE DIMENSION DUCTILE IRON PIPE DISTANCE DRIVE DOWEL
E	E. EA. ELEV. ELEC. EMB. ENGR. ENTR. E.O.P. EQ. EQUIV. EST. E.W. EXC. EXP. EXT.	CURVE EXTERNAL DISTANCE; EAST EACH ELEVATION ELECTRIC EMBANKMENT ENGINEER ENTRANCE END OF PROJECT EQUAL; EQUATION EQUIVALENT ESTIMATE EACH WAY EXCAVATION; EXCEPTION EXPANSION EXTEND; EXTENSION; EXTREME

F	FDC. FE. F.G. F.H. FIN. FL. FLR. FRTG. F.S. FT. FTG. FWD.	FIRE DEPARTMENT CONNECTION FENCE FINNISH GRADE FIRE HYDRANT FINISH FLOW LINE FLOOR FRONTAGE FORE SIGHT FOOT; FEET FOOTING FORWARD
G	GA. GAL. GALV. GAR. G.I.P. G.L. GND. GPM. GR. GRND.	GAGE GALLON GALVANIZED GARAGE GALVANIZED IRON PIPE GROUND LINE GROUND GALLONS PER MINUTE GRADE GROUND
H	HDWL. H.E.S. H.I. HORIZ. H.P. HR. H.R. HSE. HT. H.W. HWY. HYD.	HEADWALL HIGH EARLY STRENGTH HEIGHT OF INSTRUMENT HORIZONTAL HIGH PRESSURE HOUR HANDRAIL HOUSE HEIGHT HIGH WATER HIGHWAY HYDRANT
I	I.D. IN. INCL. INFO. INV. I.P.	INSIDE DIAMETER INCH INCLUDE INFORMATION INVERT IRON PIN
J	JCT. JT. JTS.	JUNCTION JOINT JOINTS
K	K.	RATE OF VERTICAL CURVATURE
L	L. LB. L.F. LONG. L.P. LT. L.W.	LENGTH OF CURVE POUND LINEAR FEET LONGITUDINAL LOW POINT or LIGHT POLE LEFT LOW WATER
M	MATL. MAX. MECH. MFG. M.H. MIN. MISC. MON M.J. M.P.H. MTR.	MATERIAL MAXIMUM MECHANICAL MANUFACTURER MANHOLE MINIMUM MISCELLANEOUS MONUMENT MECHANICAL JOINT MILES PER HOUR METER
N	N. NO. N.T.S.	NORTH NUMBER NOT TO SCALE
O	O.C. O.C.E.W. O.D. O.H. ORIG.	ON CENTER ON CENTER EACH WAY OUTSIDE DIAMETER OVERHEAD ORIGINAL

P.C.	POINT OF CURVATURE
P.C.B.	PRESTRESSED CONCRETE BEAM
P.C.C.	POINT OF COMPOUND CURVE
P.C.CONC.	PORTLAND CEMENT CONCRETE
PERF.	PERFORATED
P.I.	POINT OF INTERSECTION; PLASTICITY INDEX
P.K. NAIL	PARKER—KALON MASONRY NAIL
PL	PROPERTY LINE
P.O.C.	POINT ON CURVE
P.O.S.T.	POINT ON SUB—TANGENT
P.O.T.	POINT ON TANGENT
P.P.	POWER POLE
P & P	PLAN AND PROFILE
PR.	PAIR
P.R.C.	POINT OF REVERSE CURVE
PROJ.	PROJECT
PROP.	PROPERTY
P.S.I.	POUNDS PER SQUARE INCH
P.T.	POINT OF TANGENCY
PVC.	POLYVINYL—CHLORIDE
PVMT.	PAVEMENT
PWR.	POWER
Q.	DISCHARGE (CFS)
QTR.	QUARTER
QTY.	QUANTITY
R.	RADIUS
R.C.B.	REINFORCED CONCRETE BOX
R.C.P	REINFORCED CONCRETE PIPE
RD.	ROAD; ROOF DRAIN
RDY.	ROADWAY
REF.	REFERENCE
REINF.	REINFORCED
REQ'D.	REQUIRED
RET.	RETAINING
REV.	REVISE; REVISED
RND.	ROUND
R.P.	REFERENCE POINT
R.R.	RAILROAD
RT.	RIGHT
R/W	RIGHT OF WAY
RY.	RAILWAY
S.	SOUTH
SAN.	SANITARY
SD.	STORM DRAIN
S.D.	SIDE DRAIN; SIGHT DISTANCE
SCHED.	SCHEDULE
SEC.	SECTION
SERV.	SERVICE
SGL.	SINGLE
S.H.	STATE HIGHWAY
SHT.	SHEET
SHLDR.	SHOULDER
SIG.	SIGNAL
SIM.	SIMILAR
S.J.	SAW JOINT
SL	SECTION LINE
SP.	SPECIAL
SPEC.	SPECIFICATIONS
SQ.	SQUARE
SRVY.	SURVEY
S.S.	SANITARY SEWER
ST.	STREET
STA.	STATION
STAB.	STABILIZED
STD.	STANDARD
STL.	STEEL
STR.	STRUCTURE
SURF.	SURFACE
S.W.	SIDEWALK
SWR.	SEWER
T.	TANGENT; TOWNSHIP; THICKNESS
T.B.	TOP OF BOX
T.B.M.	TEMPORARY BENCH MARK
T.B.S.C.	TRAFFIC BOUND SURFACE COURSE
T.C.	TOP OF CURB
TEL.	TELEPHONE; TELECOMMUNICATION
TEMP.	TEMPORARY
THRU.	THROUGH
TOPO.	TOPOGRAPHY
T.P.	TURNING POINT; TOP OF PIPE
T.R.	TOP OF RAIL
TRAF.	TRAFFIC
TRANS.	TRANSFORMER
TYP.	TYPICAL

U	U.S.C.&G.S. U.S.G.S.	UNITED STATES COAST & GEODETIC SURVEY UNITED STATES GEOLOGICAL SURVEY	
V	V.G. VAR. V.C. V.C.P. VEH. VERT. VOL.	VALLEY GUTTER VARIABLE; VARIES VERTICAL CURVE VITRIFIED CLAY PIPE VEHICLE VERTICAL VOLUME	
W	W. W/ W/O W.M. WGT. WWF.	WEST WITH WITHOUT WATER METER WEIGHT WELDED WIRE FABRIC	NOTE: ABBRE USED DOCU WITHIN
X	XFMR. X-SEC X-ING	TRANSFORMER CROSS SECTION CROSSING	
Y	YD. YR.	YARD YEAR	

NOTE:
ABBREVIATIONS SHOWN ARE GENERAL ABBREVIATIONS
USED DURING THE PREPARATION OF CONSTRUCTION
DOCUMENTS. NOT ALL ABBREVIATIONS WILL BE USED
WITHIN THESE DOCUMENTS.

SURVEY LEGEND

	TREE
<i>MH</i> <i>TOP=1193.56</i>	MANHOLE
<i>CATCH BASIN</i> <i>TOP=1190.65</i>	STORM DRAIN INLET
	STORM DRAIN
—SDx—	ELECTRIC LINE UNDERGROUND
—EUG—	ELECTRIC LINE OVERHEAD
—Ex—	GAS LINE
—Gx—	SANITARY SEWER LINE
—SS—	TELEPHONE LINE UNDERGROUND
—T—	FIBER OPTIC LINE
—FO—	CABLE TELEVISION LINE
—CTV—	WATER LINE
—W—	FENCE
—x—x—x—	GUARD RAIL
—o—o—o—o—	CURB AND GUTTER
====	CURB
====	LIGHT POLE
	POWER POLE
	DOWN GUY
⊗ DG	TRAFFIC SIGNAL POLE
⊙ TS	TRAFFIC SIGNAL CONTROL BOX
□ C-BOX	TRAFFIC SIGNAL PULL BOX
□ PB	TELEPHONE RISER
□ C-RISER	WATER VALVE
○ WV	FIRE HYDRANT
⊗ FH	GAS VALVE
○ GV	SIGN
⊙ S	GUARD POST/BOLLARD
○ GP	SURVEY POINT
△ IP	CONTOUR
—1230—	

[illegible]

SAIC®
From Science to Solutions
SAIC ENERGY, ENVIRONMENT
& INFRASTRUCTURE, LLC
9400 N BROADWAY
OKLAHOMA CITY, OK 73114
405-478-5553
www.saic.com



DRAINAGE IMPROVEMENT
PLANS FOR THE STATE
CAPITOL COMPLEX
OKLAHOMA CITY, OKLAHOMA

ABBREVIATIONS AND
SURVEY LEGEND

DESIGNED BY	RCC
DRAWN BY	RCC
CHECKED BY	DGC
APPROVED BY	MRK

DATE	8/1/12
SCALE	NOT TO SCALE
PROJECT NUMBER	
4050702104	
SHEET	REV
G-002	
OF	

Filename: P:\OKC\CIV 4050702104_dcs_drainimpr\20_DESGN\40_CAD\C\702104\F100.dwg Saved: 12/22/2011 2:08:46 PM By: cooperrc
Xrefs: 702104-DCSBS01.dwg 702104-DCSVUP01.dwg 702104-DCSVUP02.dwg 702104-DCSVGP01.dwg 702104-DCSVST01.dwg 702104-DCSVSP01.dwg

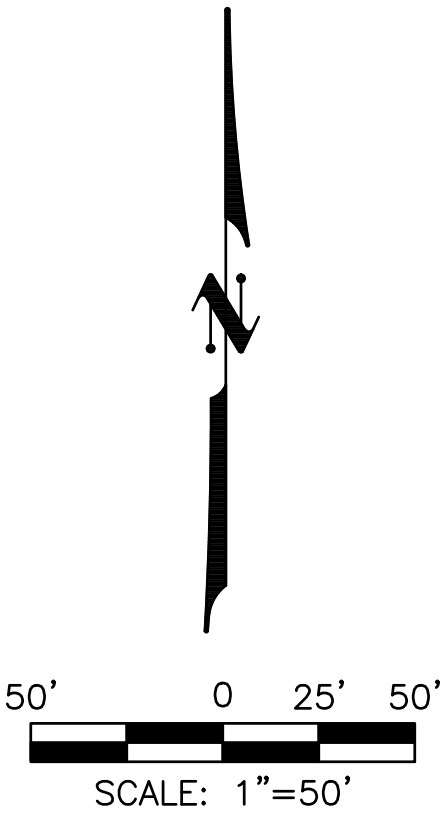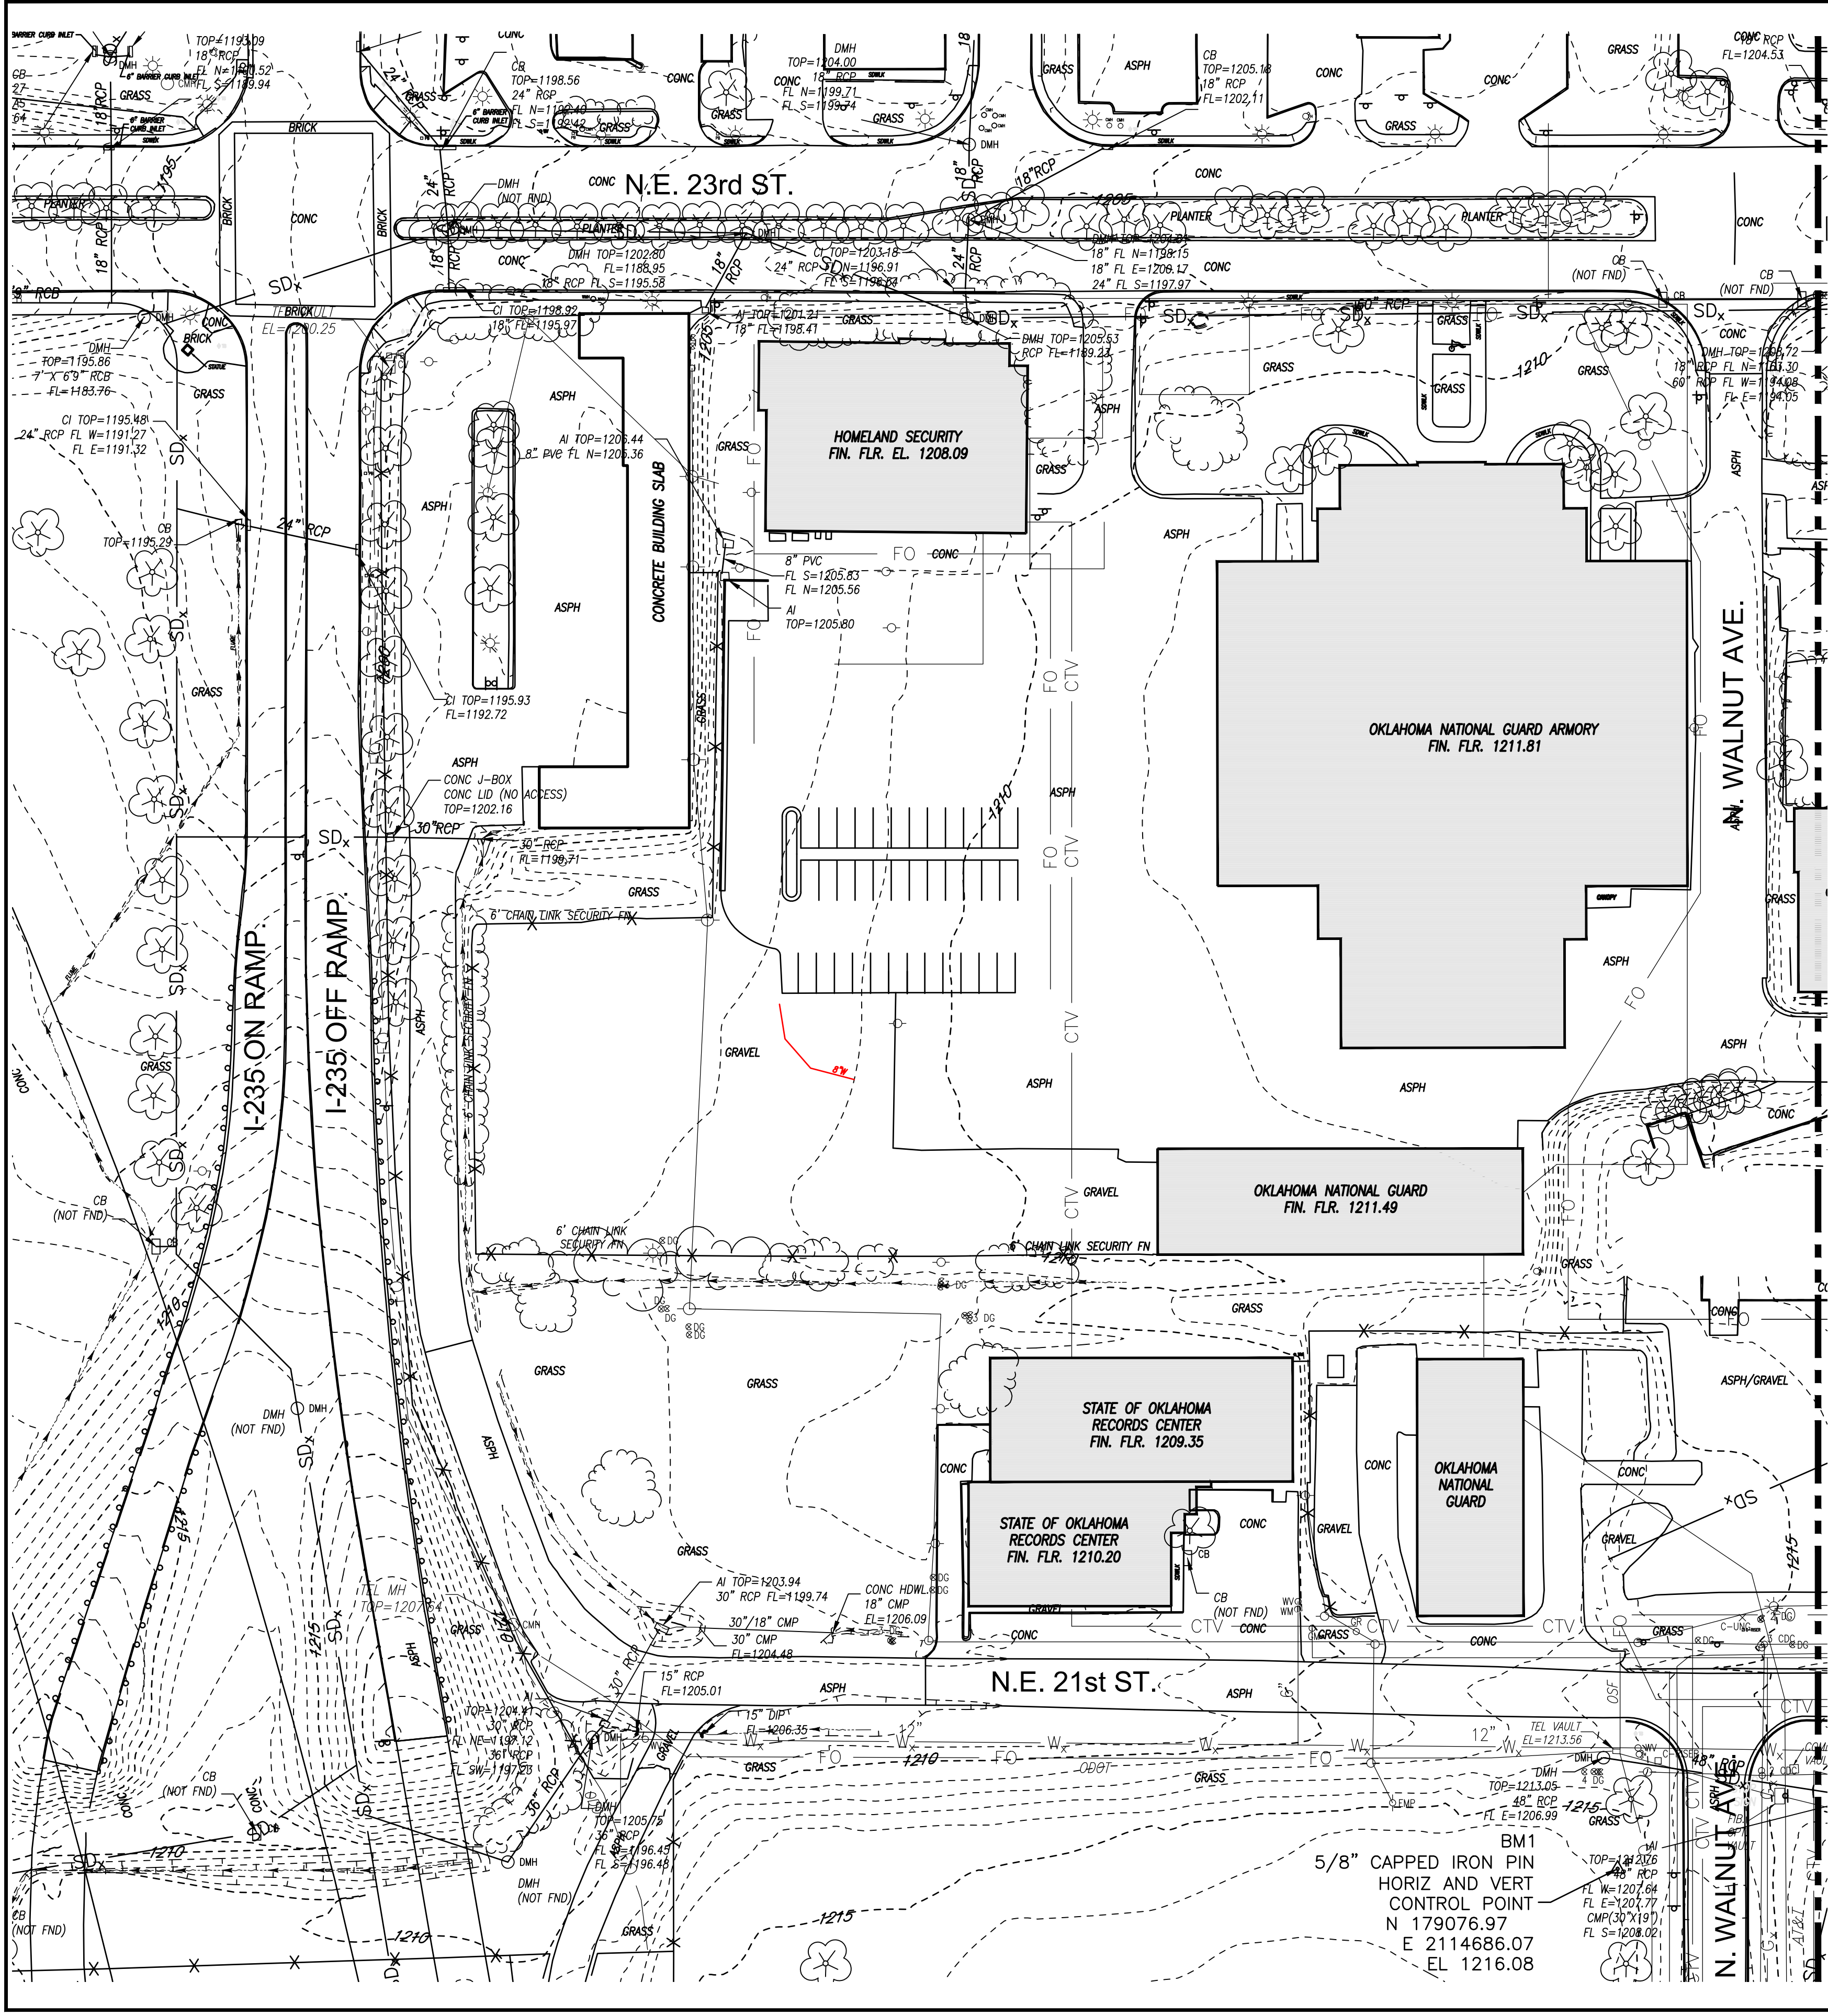

SURVEY CONTROL				
POINT #	NORTHING	EASTING	ELEVATION	DESCRIPTION
BM1	179076.97	2114686.07	1216.08	5/8" CAPPED I.P.
BM2	179165.26	2115784.00	1234.10	5/8" CAPPED I.P.
SC02	181590.33	2115263.46	1213.33	1/2" CAPPED I.P.
SC03	178222.49	2115140.77	1236.45	1/2" CAPPED I.P.
GRANDYS	184976.64	2116359.08	1195.31	1/2" CAPPED I.P.
421NE13	175975.97	2115968.14	1267.88	1/2" CAPPED I.P.

UNDERGROUND UTILITY NOTE:

1. THE LOCATIONS OF ALL UNDERGROUND UTILITIES ARE APPROXIMATE.
2. ALL UNDERGROUND UTILITIES SHALL BE FIELD VERIFIED AND MARKED PRIOR TO EXCAVATION, BORING, PROBING OR DRILLING.
3. THE LOCATION OF UNDERGROUND UTILITIES IS BASED ON SURFACE EVIDENCE AND/OR SURFACE STRUCTURES IN COMBINATION WITH INFORMATION PROVIDED TO THE SURVEYOR SUCH AS DESIGN AND/OR AS-BUILT DRAWINGS.
4. NO EXCAVATION, PROBING NOR OTHER FORM OF SUBSURFACE EXPLORATION WAS PERFORMED TO LOCATE OR VERIFY UNDERGROUND UTILITIES OR STRUCTURES.
5. THE ACTUAL LOCATIONS OF UNDERGROUND UTILITIES AND/OR STRUCTURES MAY VARY FROM THE LOCATIONS SHOWN HEREON.
6. ADDITIONAL UNDERGROUND UTILITIES AND/OR STRUCTURES MAY BE PRESENT; i.e. SOME UTILITIES AND/OR STRUCTURES MAY BE MISSING FROM THIS (THESE) DRAWINGS.

NOTES:

1. HORIZONTAL COORDINATES AND ELEVATIONS ARE IN UNITED STATES SURVEY FEET. HORIZONTAL CONTROL IS BASED ON THE OKLAHOMA NE COORDINATE SYSTEM (NORTH ZONE 3501). (NAD 1983). ELEVATIONS ARE IN FEET ABOVE SEA LEVEL USING THE NORTH AMERICAN VERTICAL DATUM 1988 (NAVD 88).
2. HORIZONTAL AND VERTICAL DATUMS BASED ON CONTROL POINTS PROVIDED BY CITY OF OKLAHOMA CITY. CIVIL ENGINEERING DEPT. POINTS USED WERE: "236R" AND "266"
3. THE AVERAGE COMBINED SCALE FACTOR FOR THE PROJECT IS: 0.99996389
4. LOCATION OF UNDERGROUND UTILITIES THAT COULD NOT BE FIELD LOCATED WERE TRANSFERRED FROM EXISTING MAPPING PROVIDED BY OKLAHOMA DEPARTMENT OF TRANSPORTATION AND CITY OF OKLAHOMA CITY OTHER UTILITIES MAY EXIST IN THE PROJECT AREA.
5. BASE MAPPING, DATED JULY 2, 2008, PERFORMED BY AERIAL DATA SERVICES.

NO.	DATE	RECORD DRAWING	DESCRIPTION OF REVISION OR ISSUE	BY	APP'D
1	1/21/15				



From Science to Solutions
SAC ENERGY, ENVIRONMENT
& INFRASTRUCTURE, LLC
OKLAHOMA CITY, OK 73114
405-478-5553
www.sailc.com

CERT. OF AUTH. # 3722, EXP. 06/30/2014


DRAINAGE IMPROVEMENT
PLANS FOR THE STATE
CAPITOL COMPLEX
OKLAHOMA CITY, OKLAHOMA
EXISTING SITE CONDITIONS 1

DESIGNED BY	DFB
DRAWN BY	CAS/BPH
CHECKED BY	RCC
APPROVED BY	MRK

DATE	8/1/12
SCALE	1" = 50'
PROJECT NUMBER	4050702104
SHEET	VF101
OF	

File: P:\OK\CV\4050702104_dcs_drainimpr\20_DESIGN\40_CAD\CV\20104VF100.dwg Saved: 12/22/2011 2:08:46 PM By: cooperrc
Xrefs: 702104-DCSVP01.dwg 702104-DCSVP02.dwg 702104-DCSVP01.dwg 702104-DCSVP02.dwg 702104-DCSVP01.dwg 702104-DCSVP02.dwg

MATCH LINE SHEET VF101

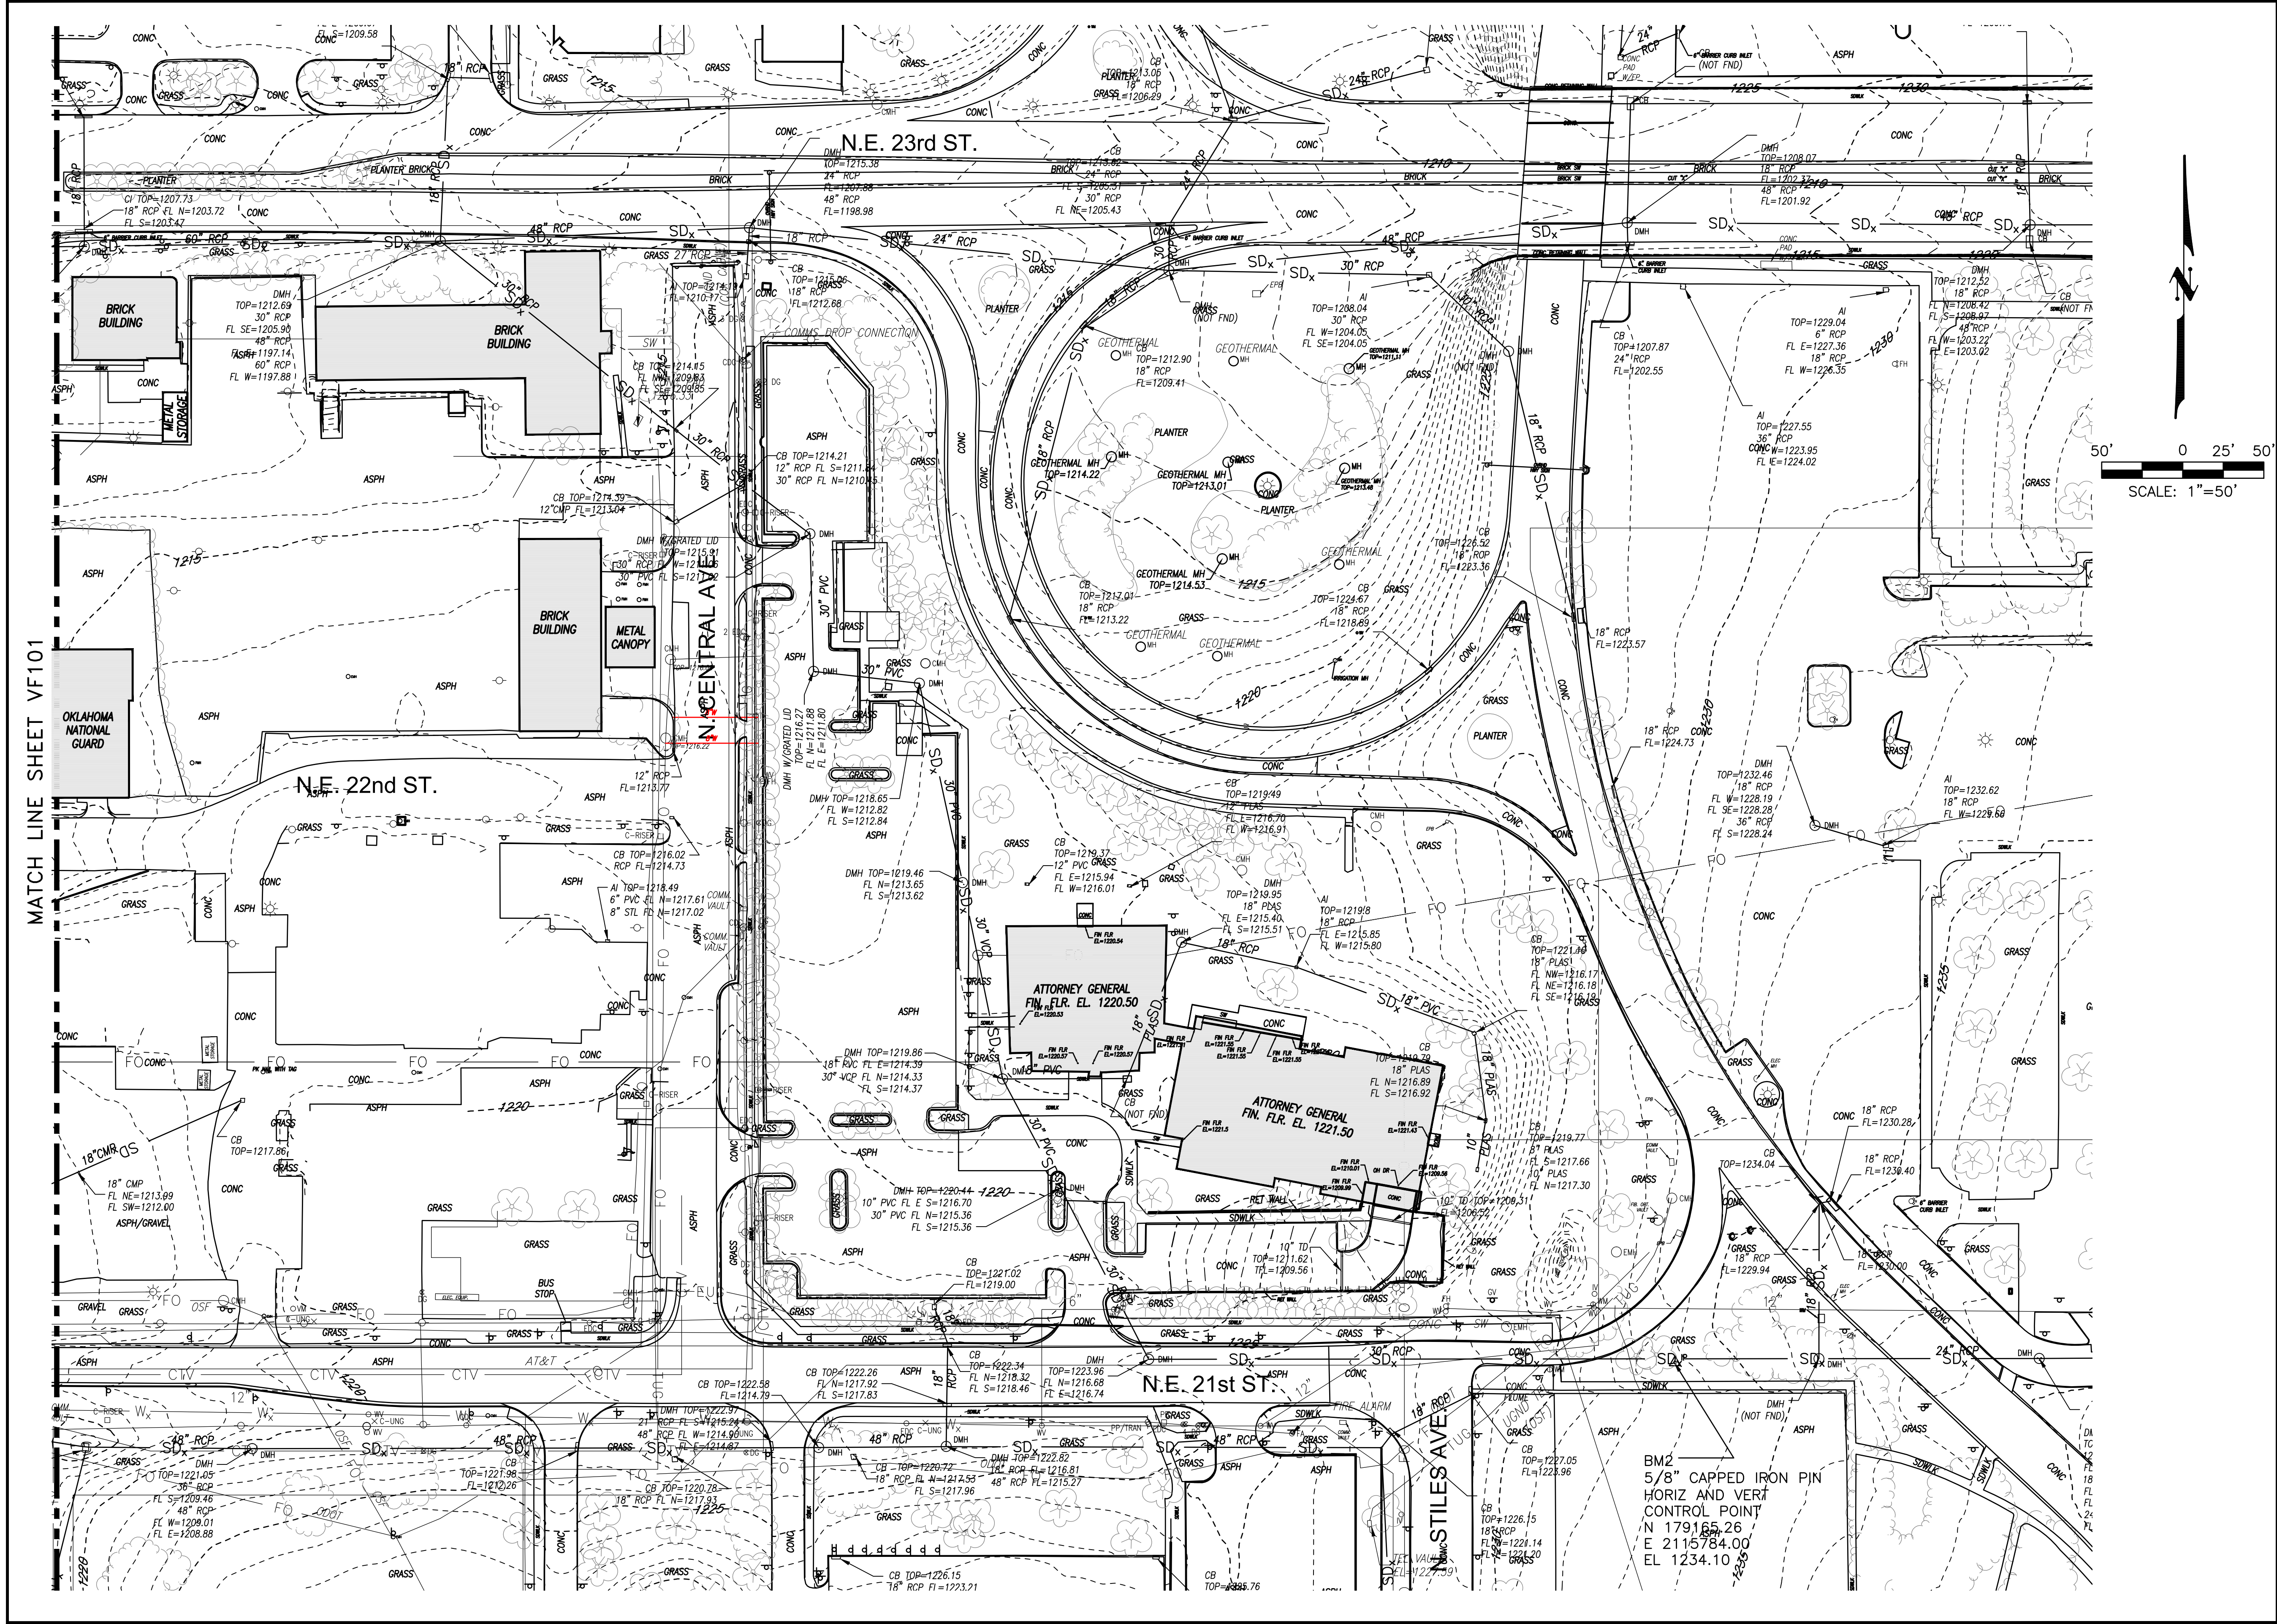

NO.	DATE	DESCRIPTION OF REVISION OR ISSUE	BY	APP'D
1	1/21/15	RECORD DRAWING		

SALC
From Science to Solutions
SAC ENERGY, ENVIRONMENT
& INFRASTRUCTURE, LLC
OKLAHOMA CITY, OK 73114
405-478-5553
www.salcc.com

CERT. OF AUTH. # 3722, EXP. 06/30/2014


DESIGNED BY DFB
DRAWN BY CAS/BPH
CHECKED BY RCC
APPROVED BY MRK

DATE 8/1/12
SCALE 1" = 50'
PROJECT NUMBER 4050702104
SHEET VF102
OF

DESIGNED BY DFB
DRAWN BY CAS/BPH
CHECKED BY RCC
APPROVED BY MRK

DATE 8/1/12
SCALE 1" = 50'
PROJECT NUMBER 4050702104
SHEET VF102
OF

Filename: P:\OKC\CIV\4050702104_dcs_drainimpr\20_DESGN\40_CAD\C\702104\F100.dwg Saved: 12/22/2011 2:09:46 PM By: cooperrc
Xrefs: 702104-DCBS01.dwg 702104-DCSVUP01.dwg 702104-DCSVUP02.dwg 702104-DCSVGP01.dwg 702104-DCSVST01.dwg 702104-DCSVSP01.dwg

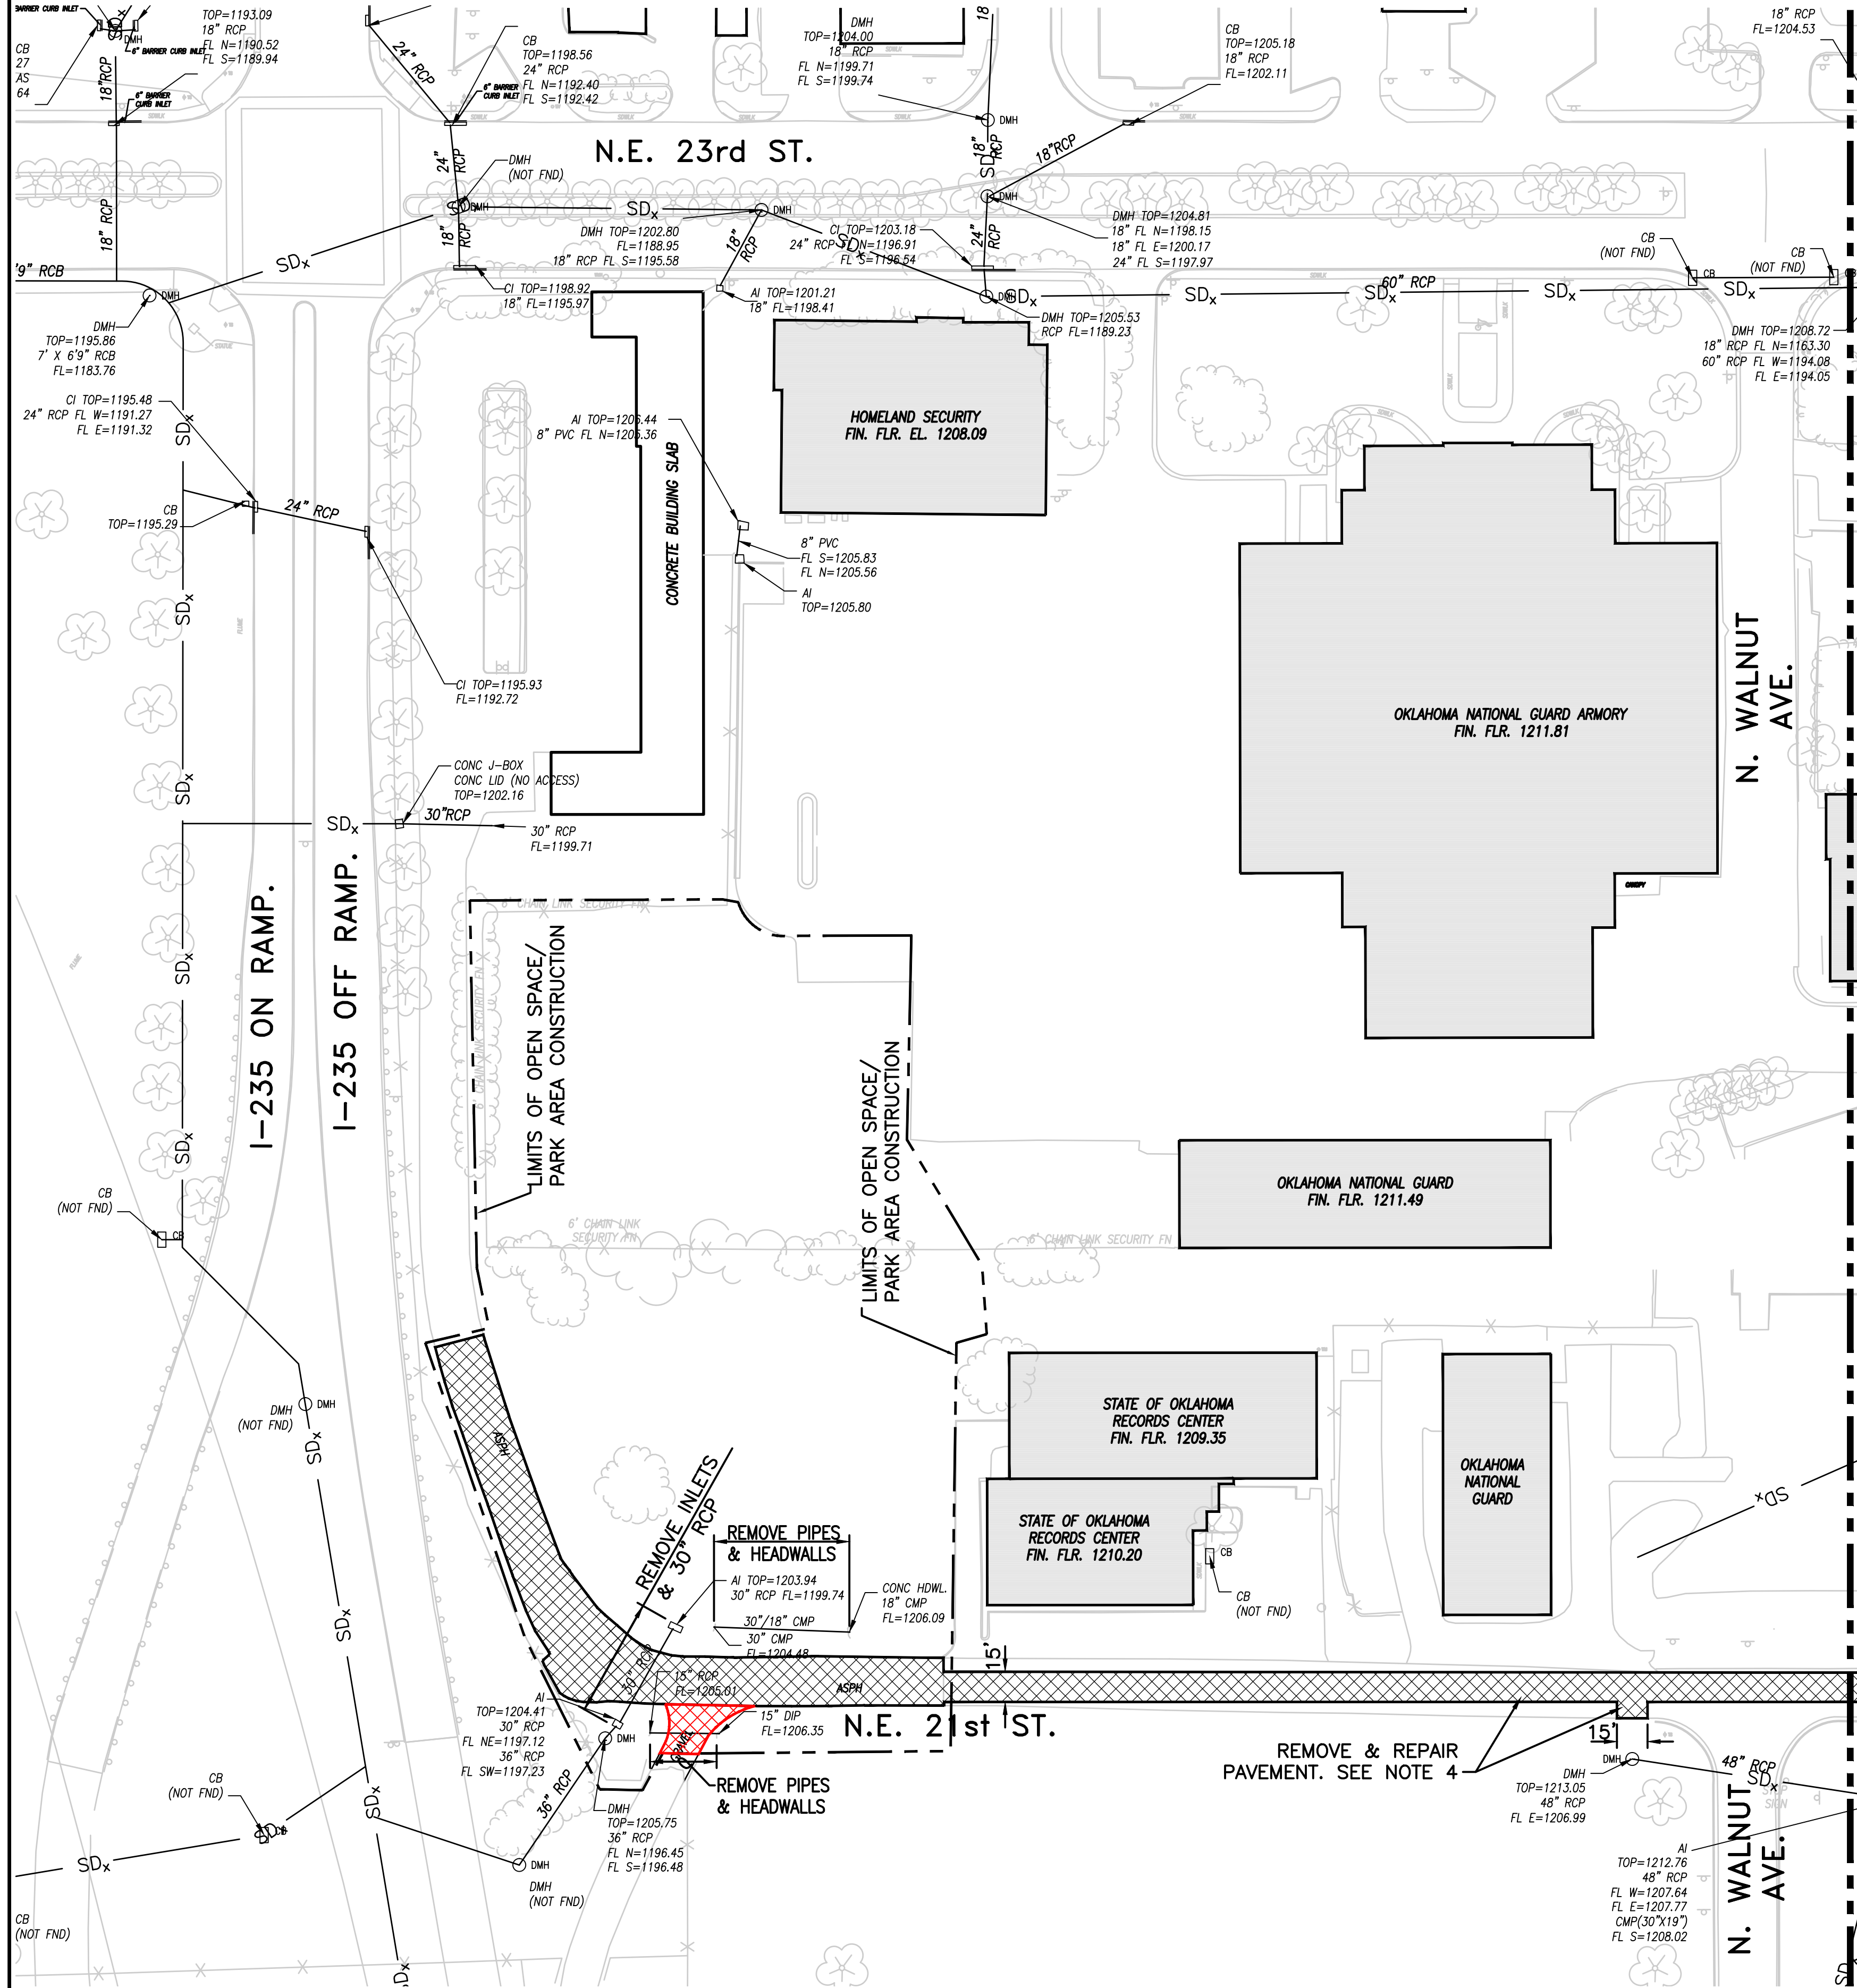

DEMOLITION NOTES:

1. CLEAR AND GRUB EXISTING VEGETATION WITHIN LIMITS OF OPEN SPACE/PARK AREA CONSTRUCTION.
2. REMOVE ALL EXISTING ABOVE GROUND SITE FEATURES WITHIN LIMITS OF OPEN SPACE/PARK AREA CONSTRUCTION.
3. COORDINATE RELOCATION OF OVERHEAD ELECTRIC LINES AND APPURTENANCES WITHIN THE LIMITS OF OPEN SPACE/PARK AREA CONSTRUCTION WITH OG&E.
4. SEE OKLAHOMA CITY STANDARD DETAIL SHEET D-201 FOR PAVEMENT REPAIR DETAIL.

DESIGNED BY DFB
DRAWN BY CAS/BPH
CHECKED BY RCC
APPROVED BY MRK

DATE 8/1/12
SCALE 1" = 50'
PROJECT NUMBER 4050702104
SHEET CD101
OF


SALIC
From Science to Solutions
SALIC ENERGY, ENVIRONMENT
& INFRASTRUCTURE, LLC
OKLAHOMA CITY, OK 73114
405-475-5553
www.salic.com

CERT. OF AUTH. # 3722, EXP. 06/30/2014

NO.	DATE	DESCRIPTION OF REVISION OR ISSUE	BY	APP'D
1	1/21/15	RECORD DRAWING		

STORMWATER MANAGEMENT PLAN


[illegible]

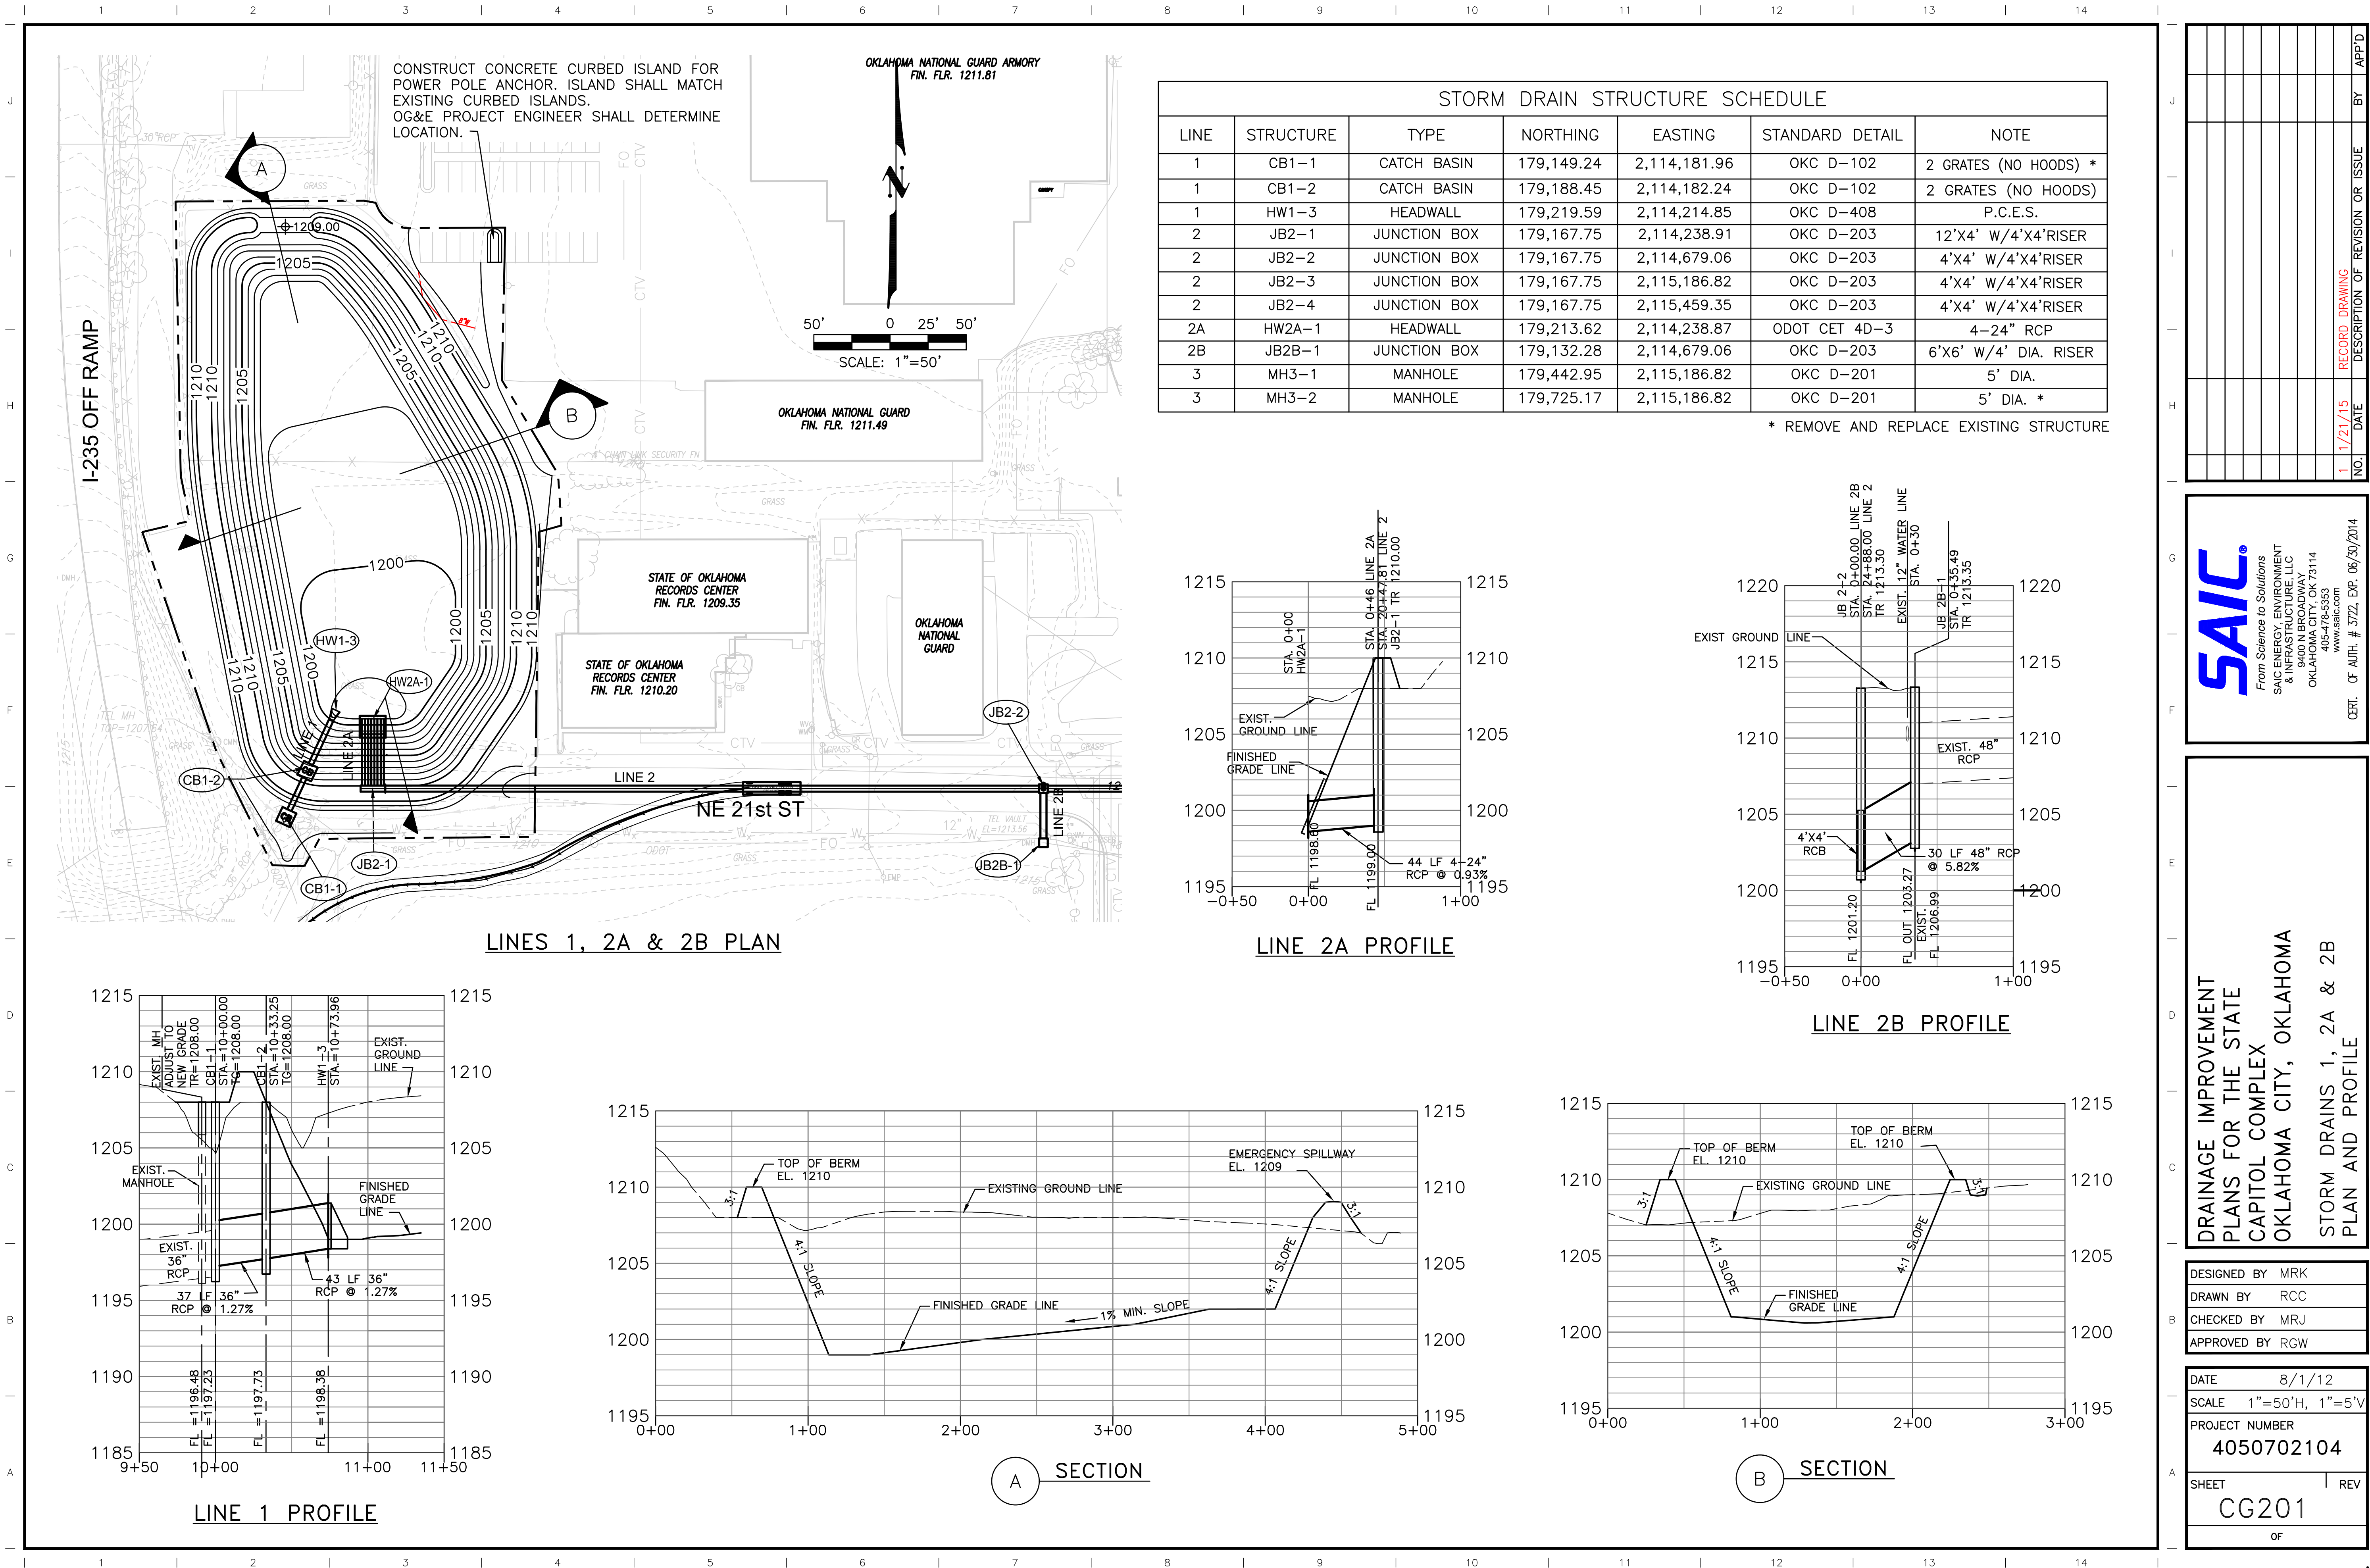


LINES 1, 2A & 2B PLAN

STORM DRAIN STRUCTURE SCHEDULE						
LINE	STRUCTURE	TYPE	NORTHING	EASTING	STANDARD DETAIL	NOTE
1	CB1-1	CATCH BASIN	179,149.24	2,114,181.96	OKC D-102	2 GRATES (NO HOODS) *
1	CB1-2	CATCH BASIN	179,188.45	2,114,182.24	OKC D-102	2 GRATES (NO HOODS)
1	HW1-3	HEADWALL	179,219.59	2,114,214.85	OKC D-408	P.C.E.S.
2	JB2-1	JUNCTION BOX	179,167.75	2,114,238.91	OKC D-203	12'X4' W/4'X4'RISER
2	JB2-2	JUNCTION BOX	179,167.75	2,114,679.06	OKC D-203	4'X4' W/4'X4'RISER
2	JB2-3	JUNCTION BOX	179,167.75	2,115,186.82	OKC D-203	4'X4' W/4'X4'RISER
2	JB2-4	JUNCTION BOX	179,167.75	2,115,459.35	OKC D-203	4'X4' W/4'X4'RISER
2A	HW2A-1	HEADWALL	179,213.62	2,114,238.87	ODOT CET 4D-3	4-24" RCP
2B	JB2B-1	JUNCTION BOX	179,132.28	2,114,679.06	OKC D-203	6'X6' W/4' DIA. RISER
3	MH3-1	MANHOLE	179,442.95	2,115,186.82	OKC D-201	5' DIA.
3	MH3-2	MANHOLE	179,725.17	2,115,186.82	OKC D-201	5' DIA. *


* REMOVE AND REPLACE EXISTING STRUCTURE

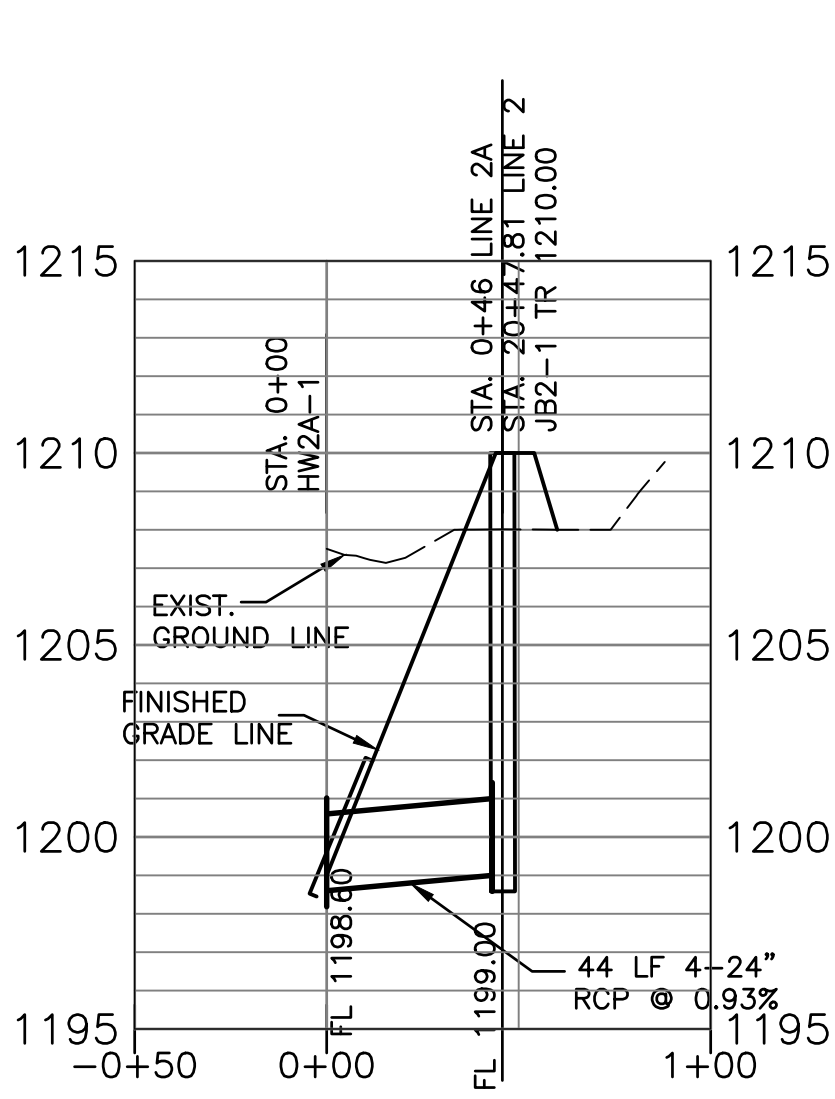


LINE 2A PROFILE

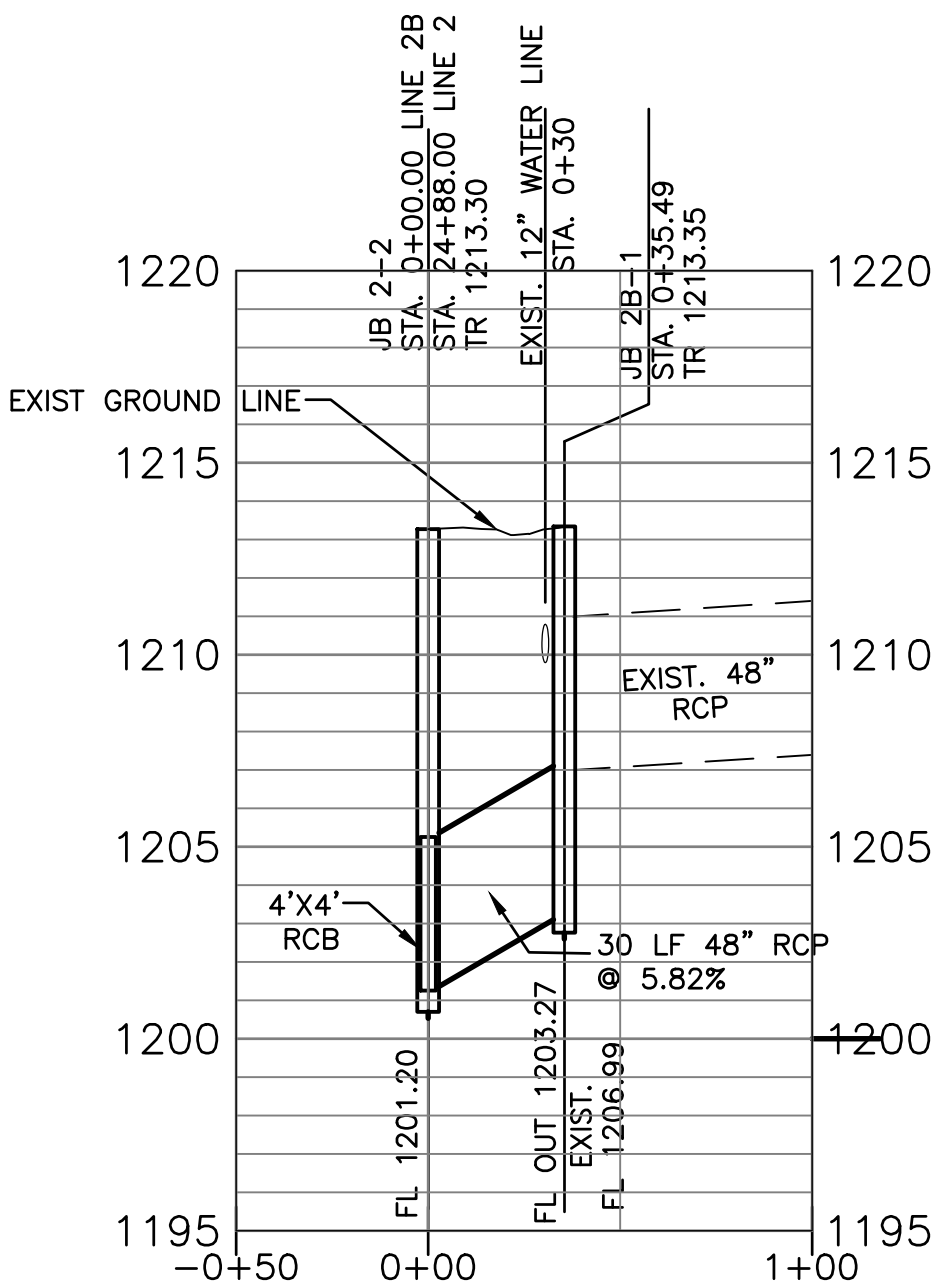


LINE 2B PROFILE

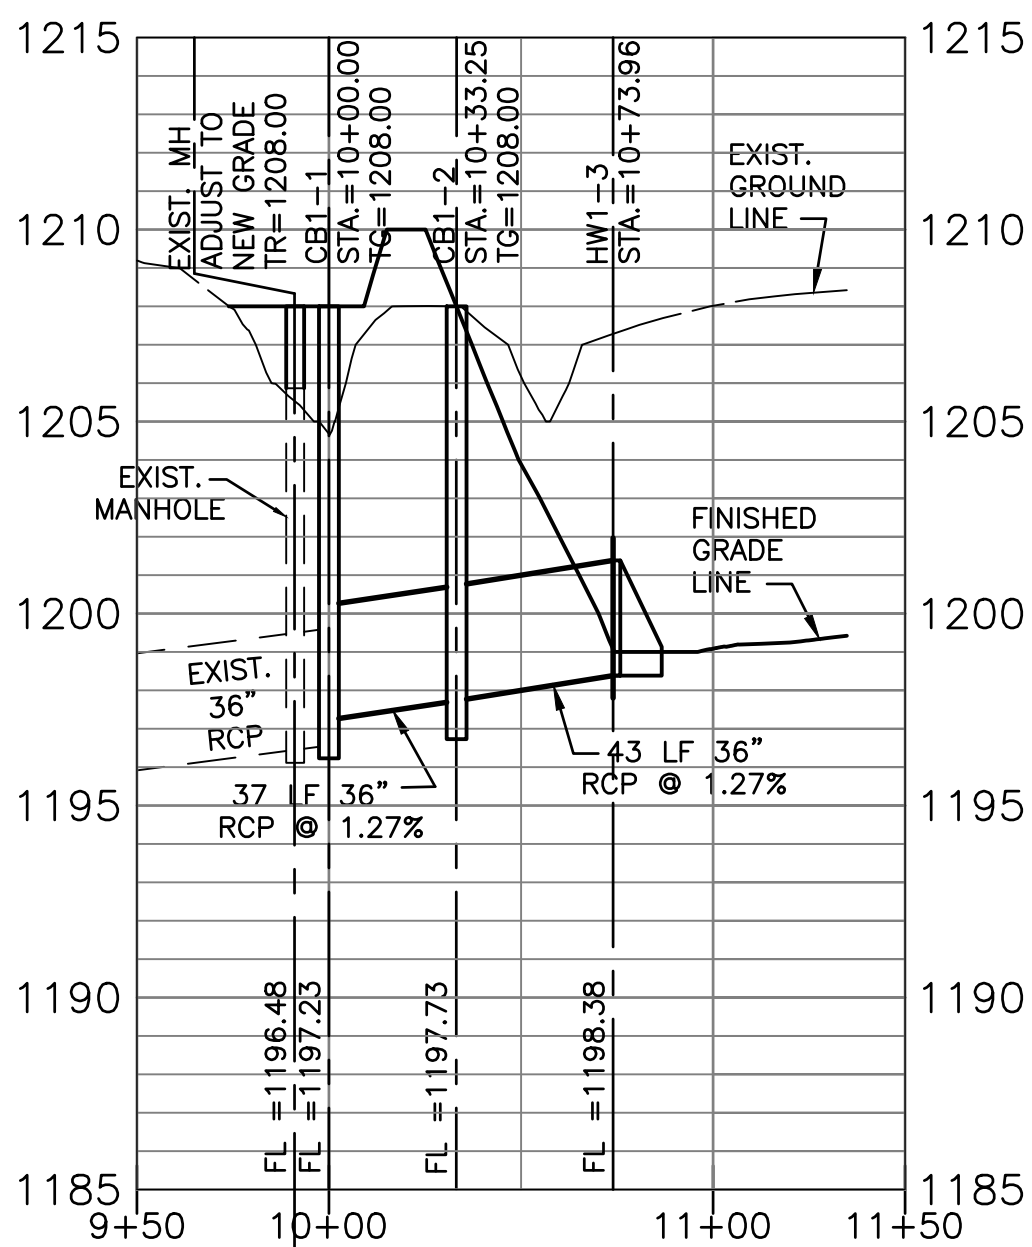

LINE 1 PROFILE

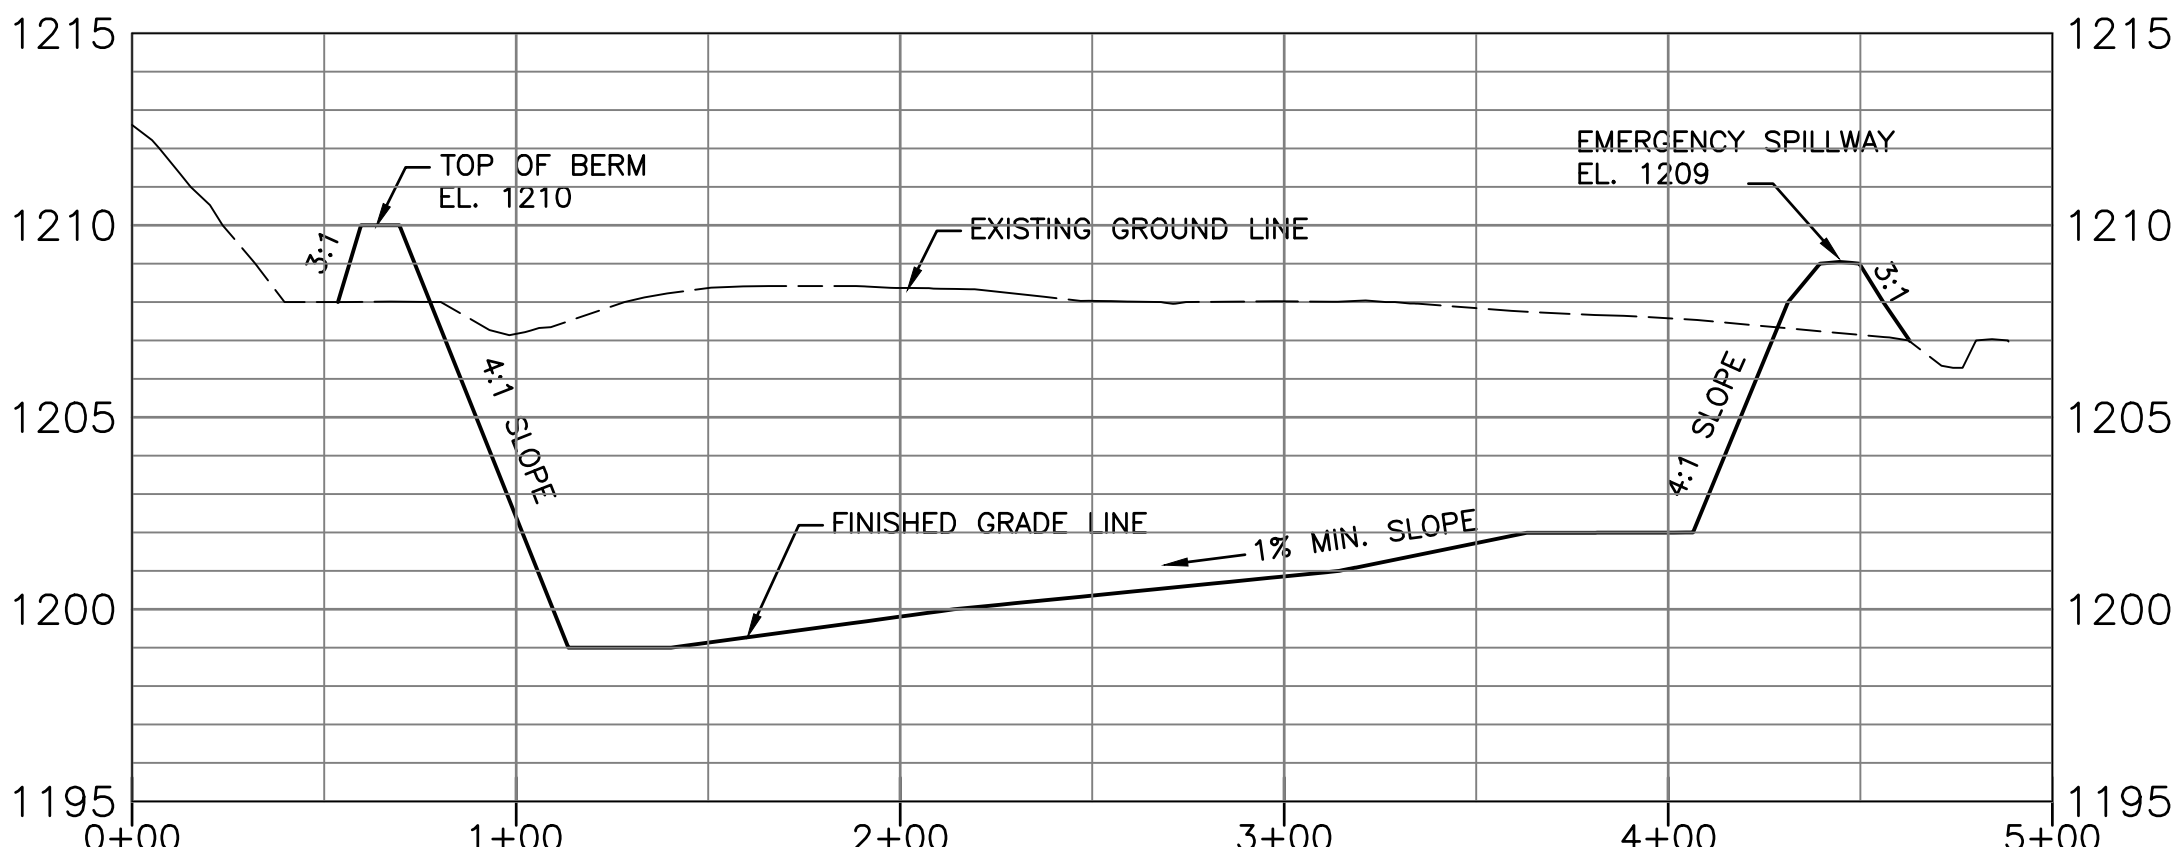

A SECTION

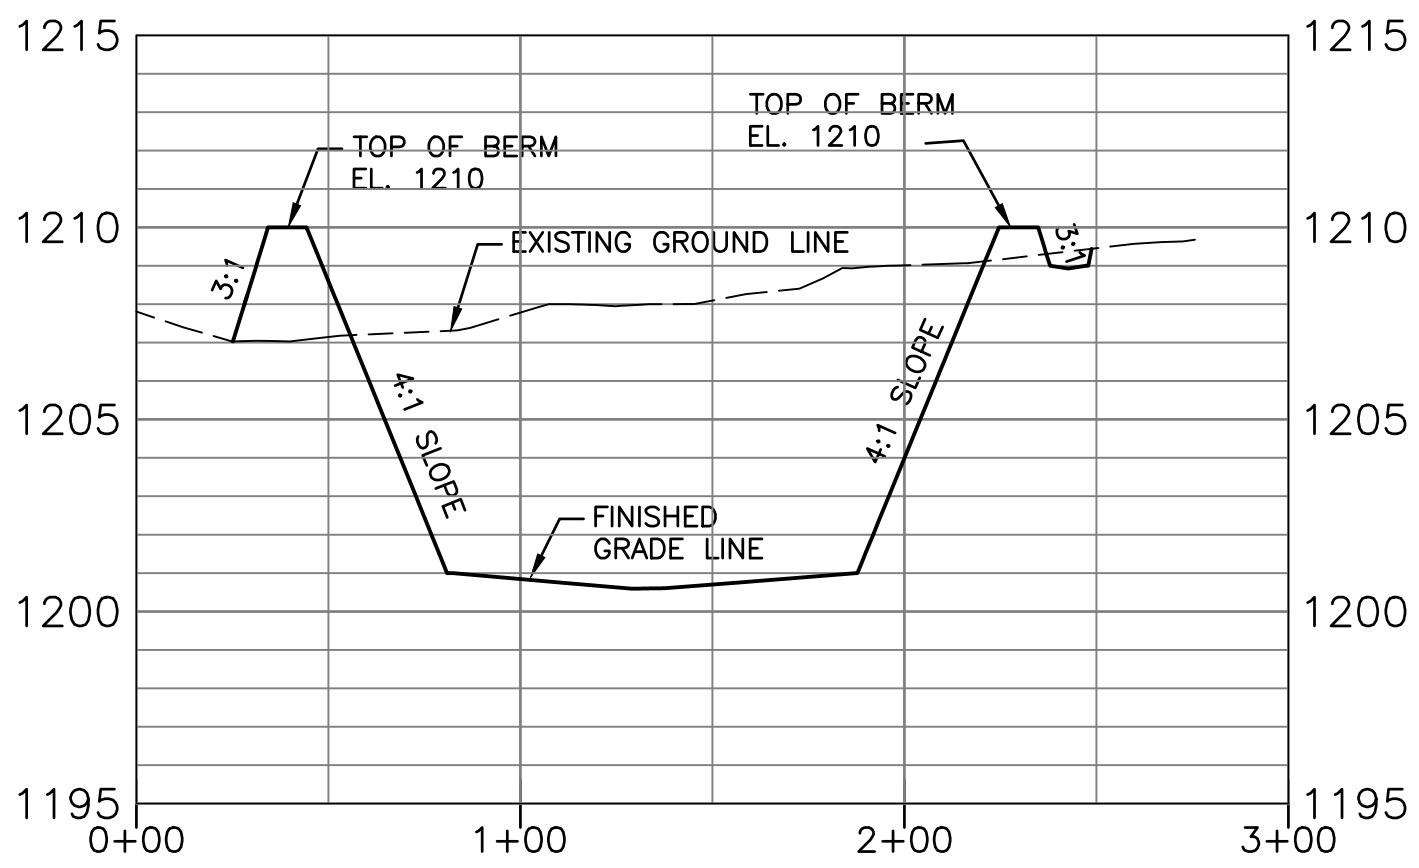

B SECTION

NO.	DATE	DESCRIPTION OF REVISION OR ISSUE	BY	APP'D
1	1/21/15	RECORD DRAWING		

SALC
From Science to Solutions
SALC ENERGY, ENVIRONMENT
& INFRASTRUCTURE, LLC
OKLAHOMA CITY, OK 73114
405-478-5553
www.salcc.com



CERT. OF AUTH. # 3722, EXP. 06/30/2014

DESIGNED BY MRK
DRAWN BY RCC
CHECKED BY MRJ
APPROVED BY RGW

DATE 8/1/12
SCALE 1"=50'H, 1"=5'V
PROJECT NUMBER 4050702104

SHEET CG201
REV

OF

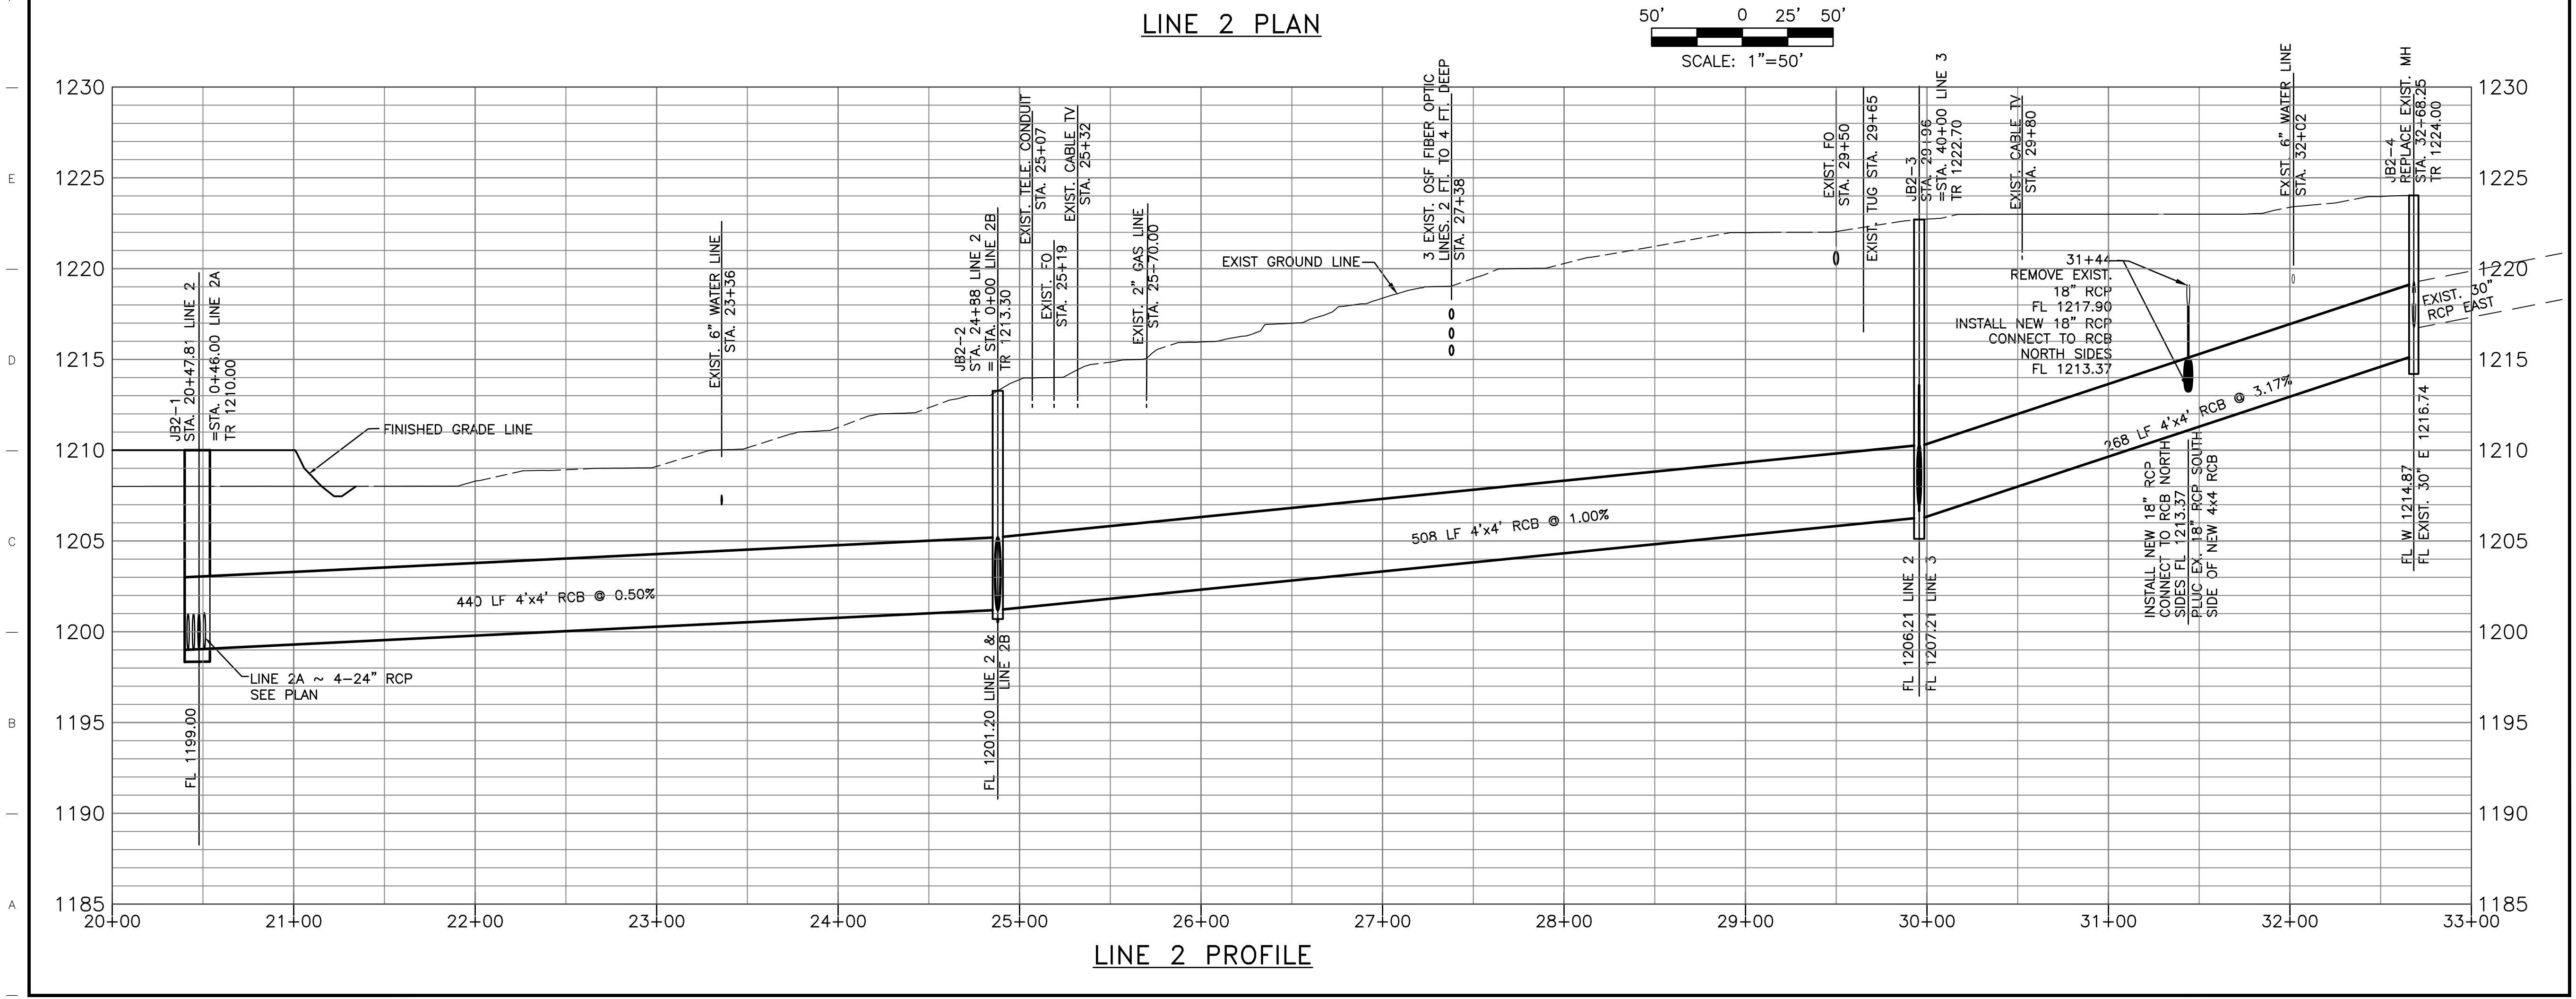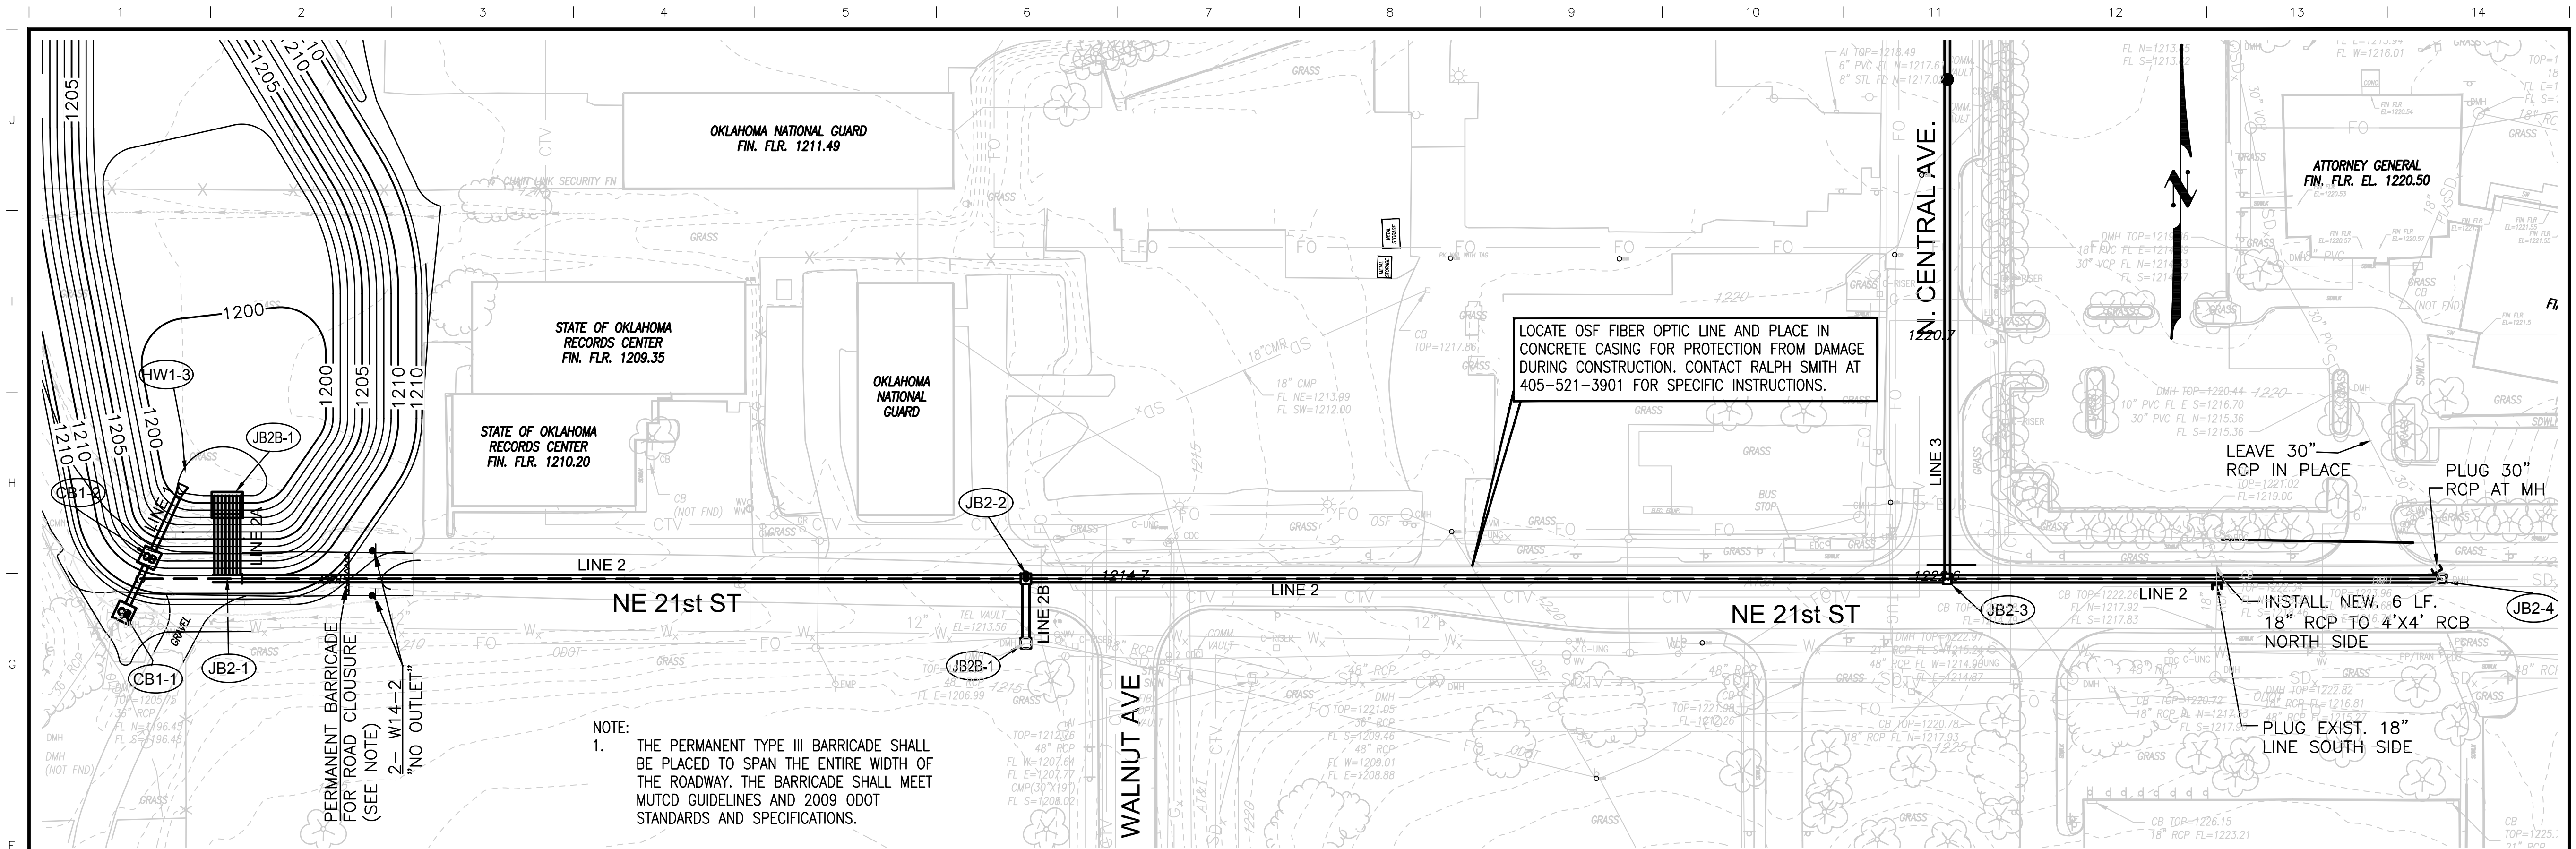

NO.	DATE	DESCRIPTION OF REVISION OR ISSUE	BY	APP'D
1	1/21/15	RECORD DRAWING		



From Science to Solutions
SAC ENERGY, ENVIRONMENT
& INFRASTRUCTURE, LLC
OKLAHOMA CITY, OK 73114
405-478-5553
www.saic.com


CERT. OF AUTH. # 3722, EXP. 06/30/2014

**DRAINAGE IMPROVEMENT
PLANS FOR THE STATE
CAPITOL COMPLEX
OKLAHOMA CITY, OKLAHOMA**


**STORM DRAIN LINE 2
PLAN AND PROFILE**

DESIGNED BY	MRK
DRAWN BY	RCC
CHECKED BY	MRJ
APPROVED BY	RGW

DATE	8/1/12
SCALE	1"=50'H, 1"=5'V
PROJECT NUMBER	4050702104
SHEET	CG202
REV	OF

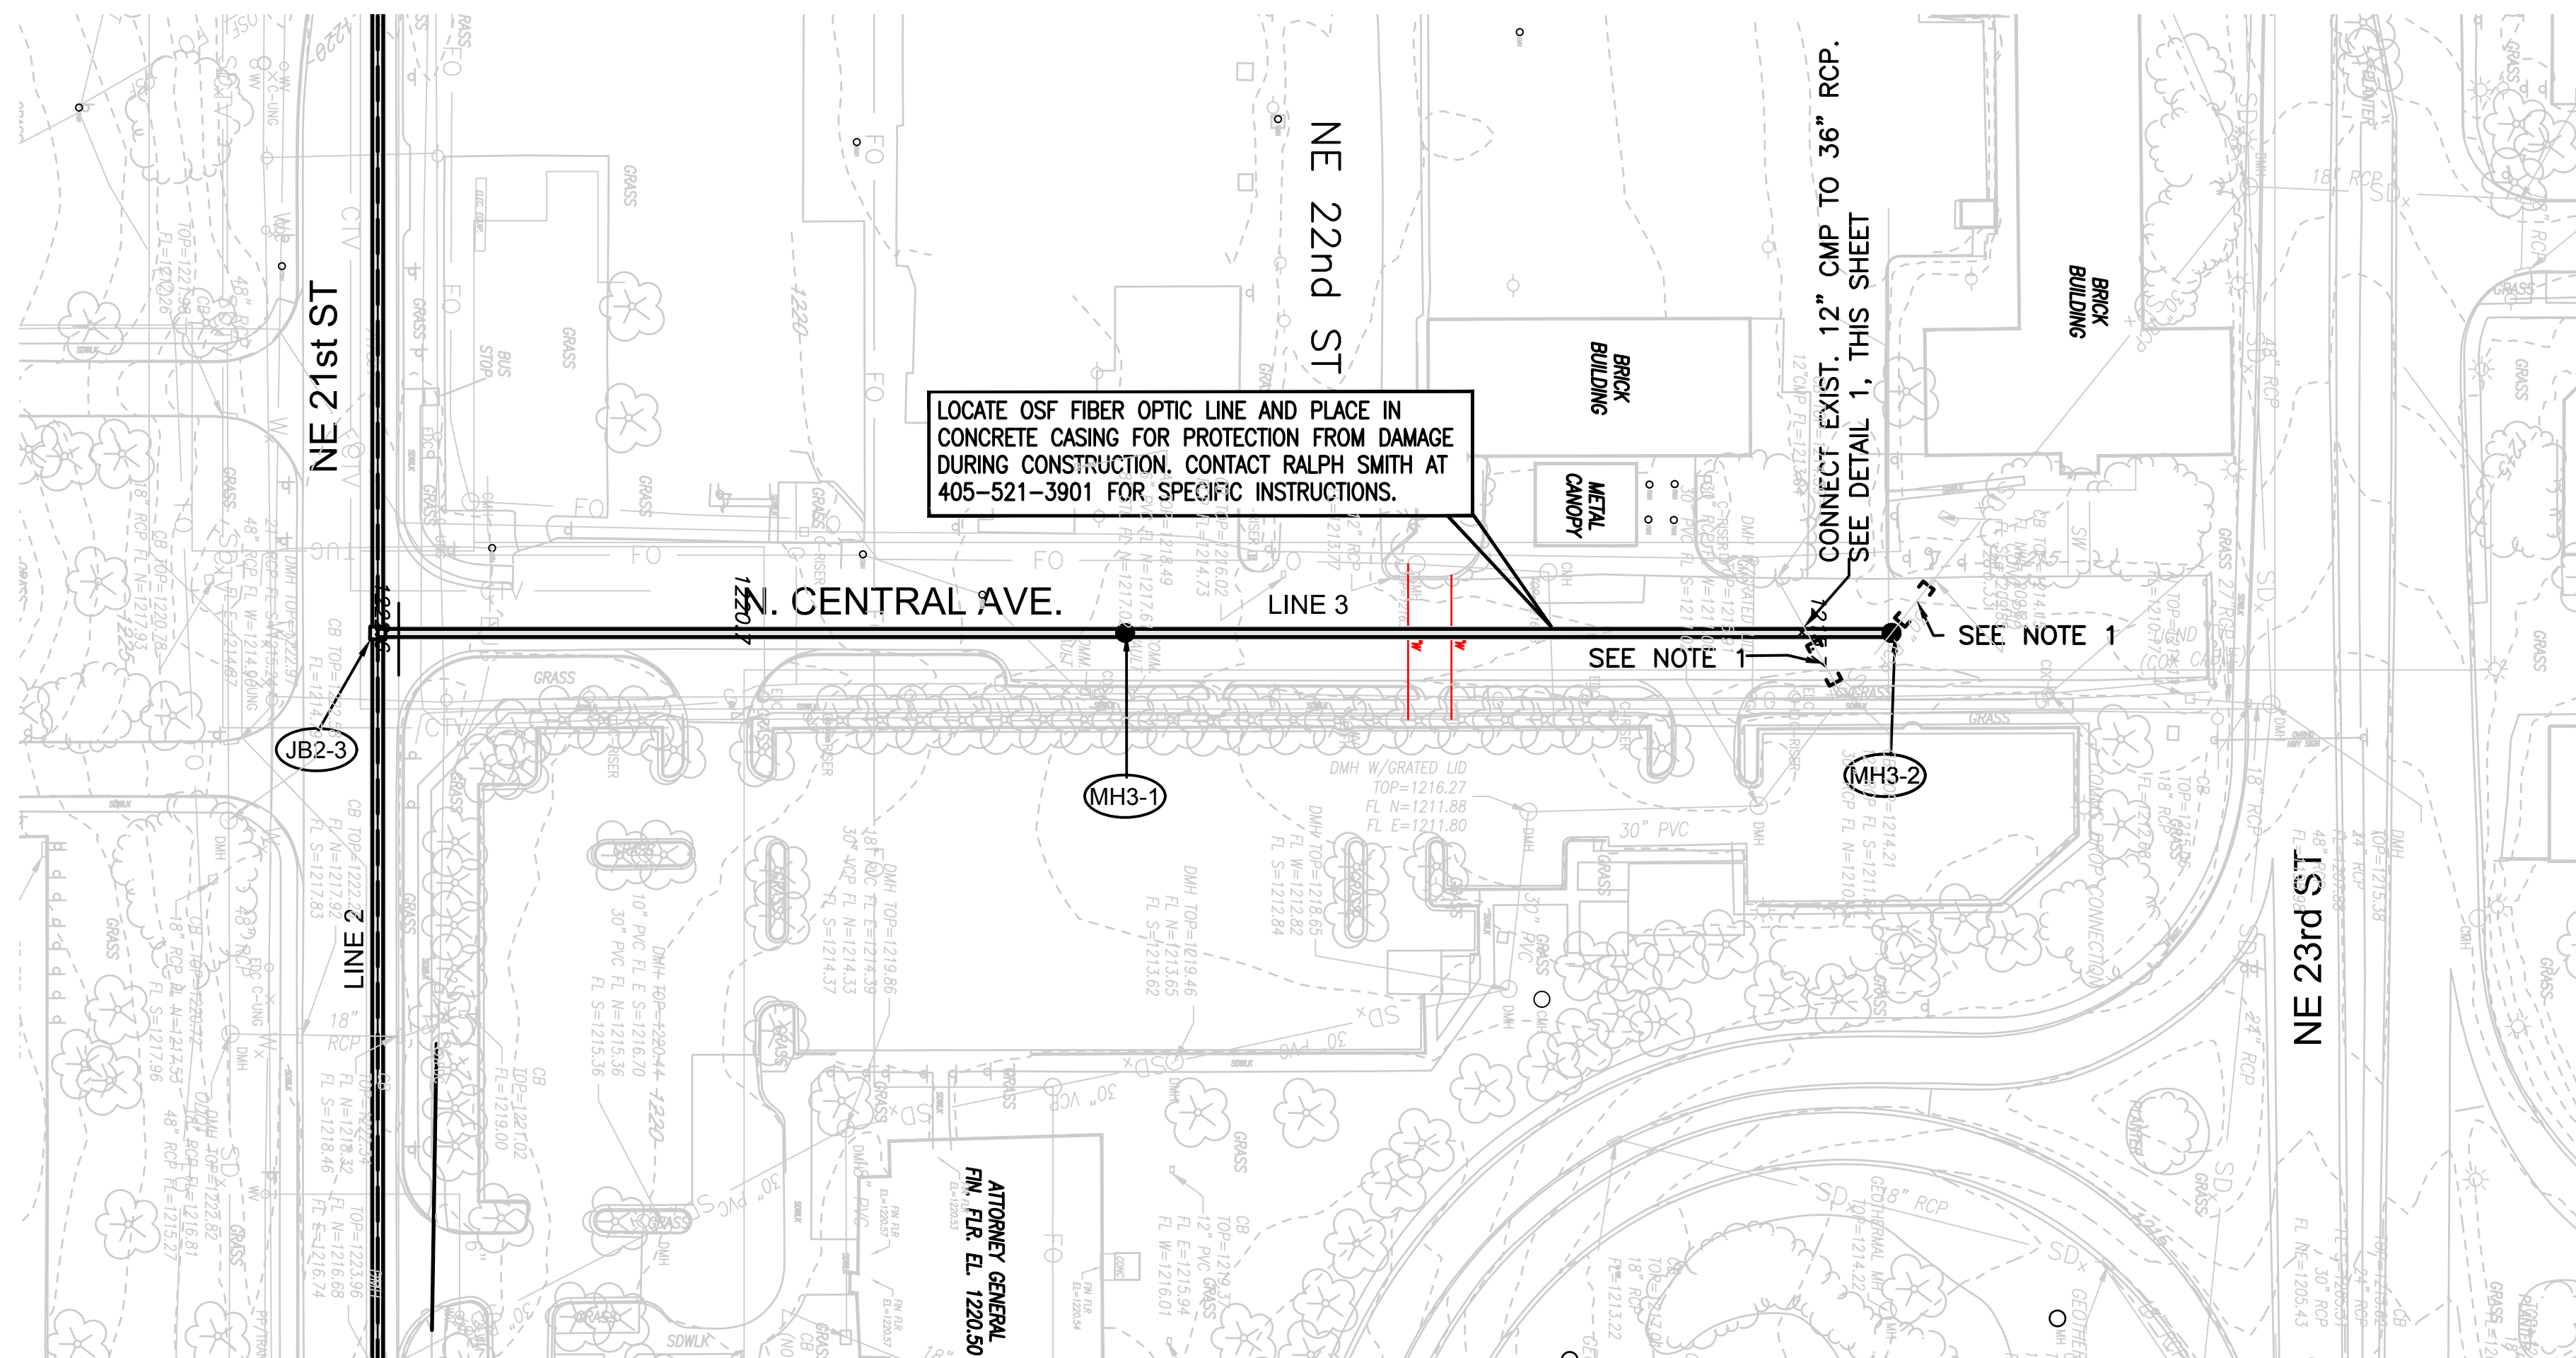

LINE 3 PLAN

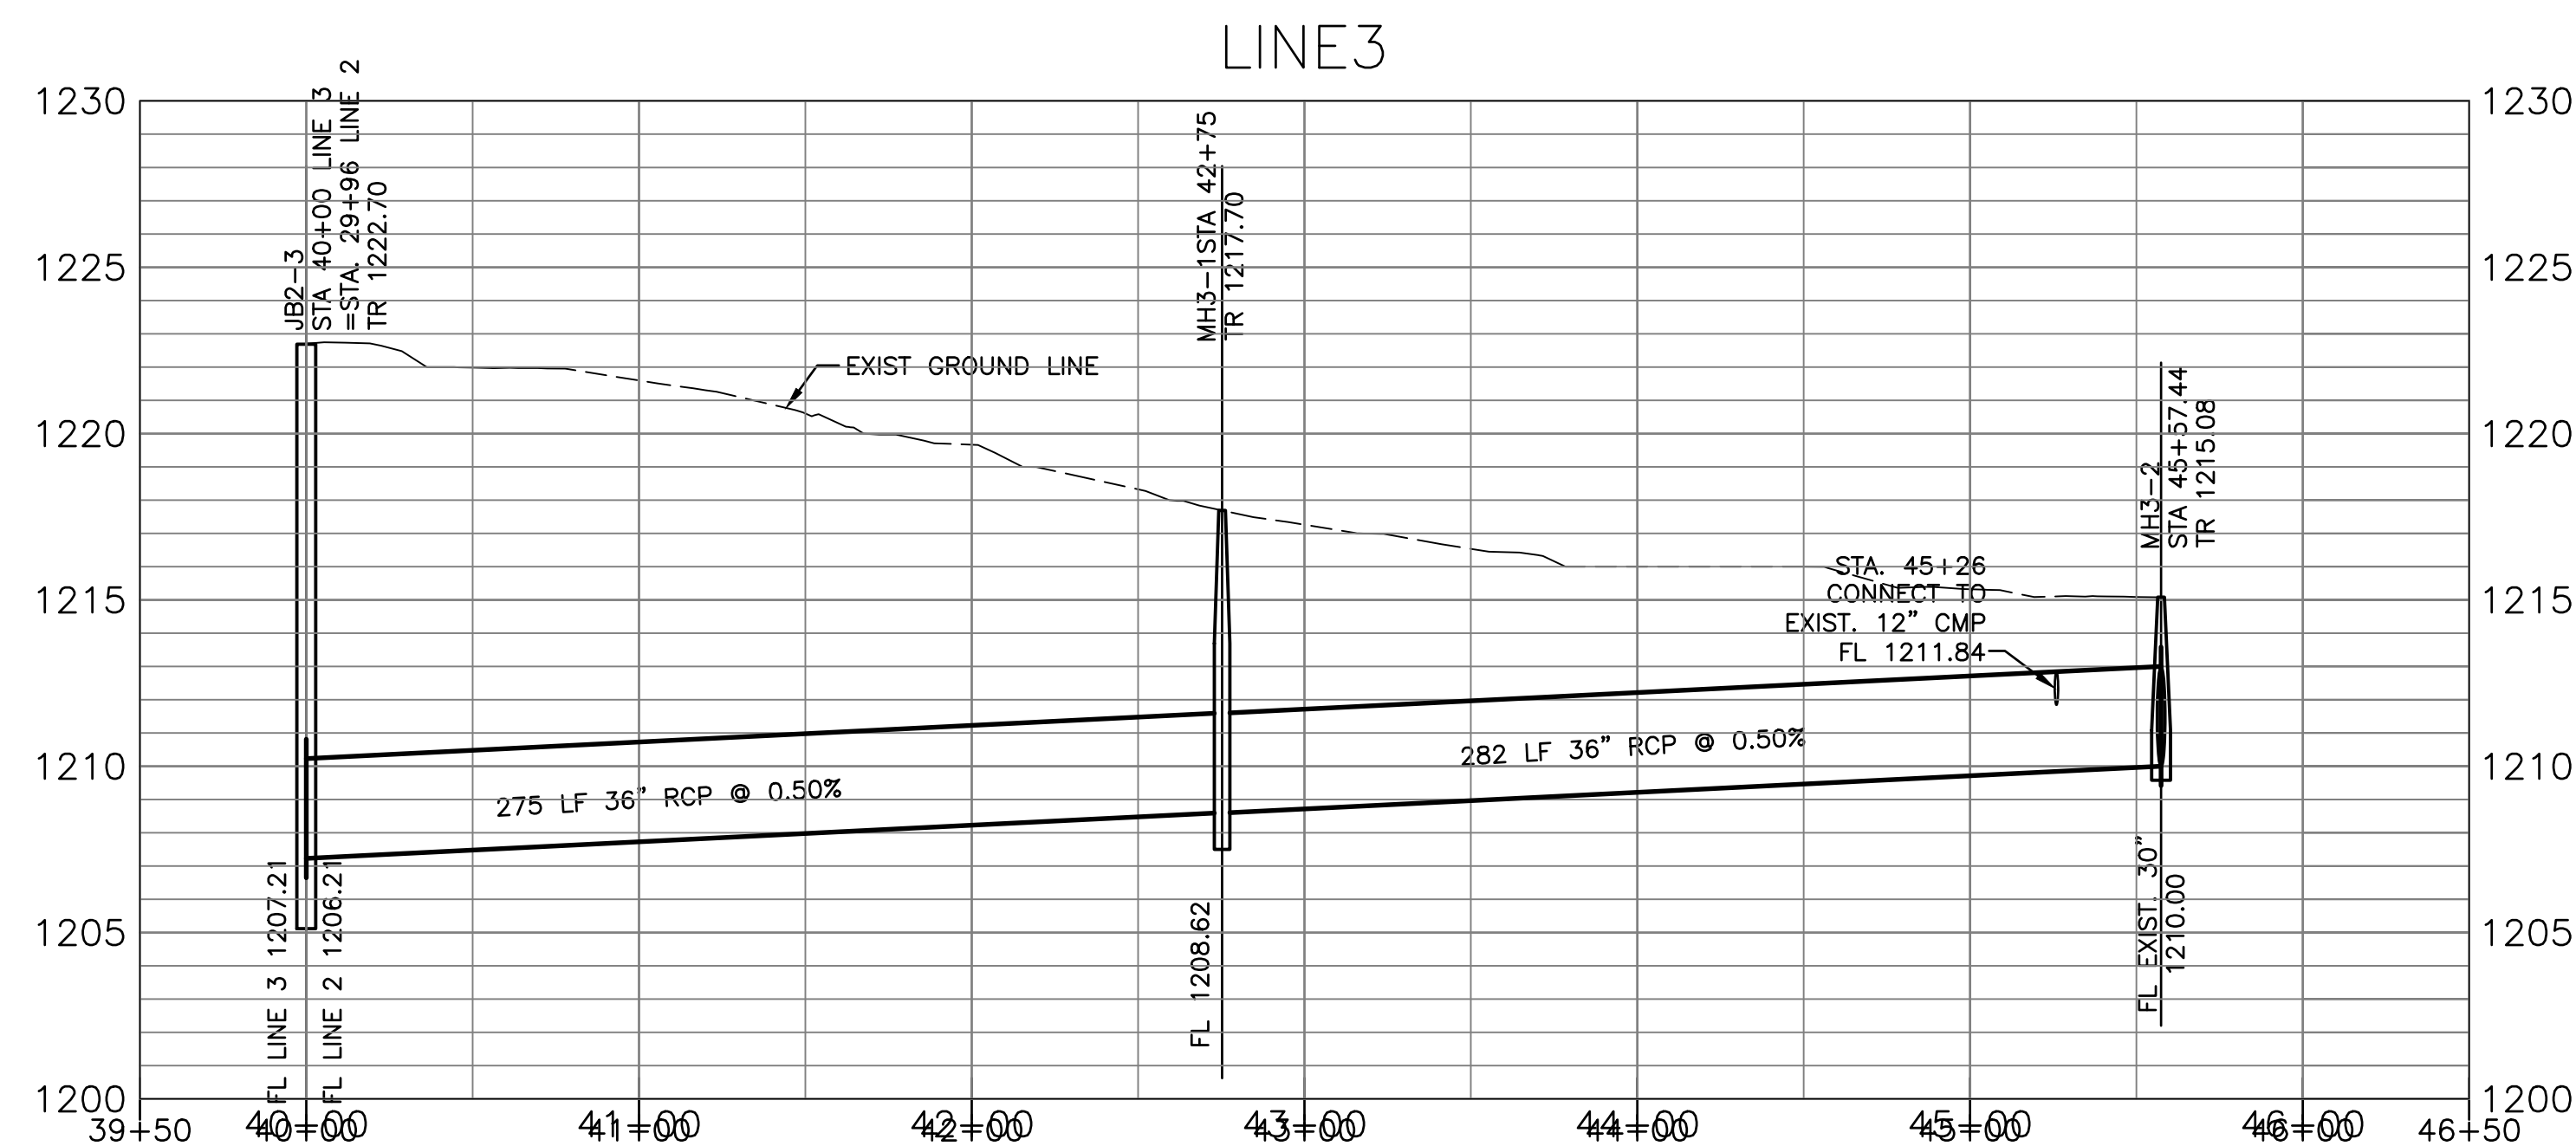

1 PIPE TAP

A ————— B
C ————— D
E ————— F
G ————— H
I ————— J

- A ————— B
C ————— D
E ————— F
G ————— H
I ————— J



PC: 1+24:50




	D
	D
	C
	A
	D
	S
	F
	S

[illegible]



	D		
	D		
	C		
	A		
	D		
	S		
	F		
	S		

D				
D				
C				
A				
D				
S				
F				

	D
	D
	C
	A
	D
	S
	F
	S

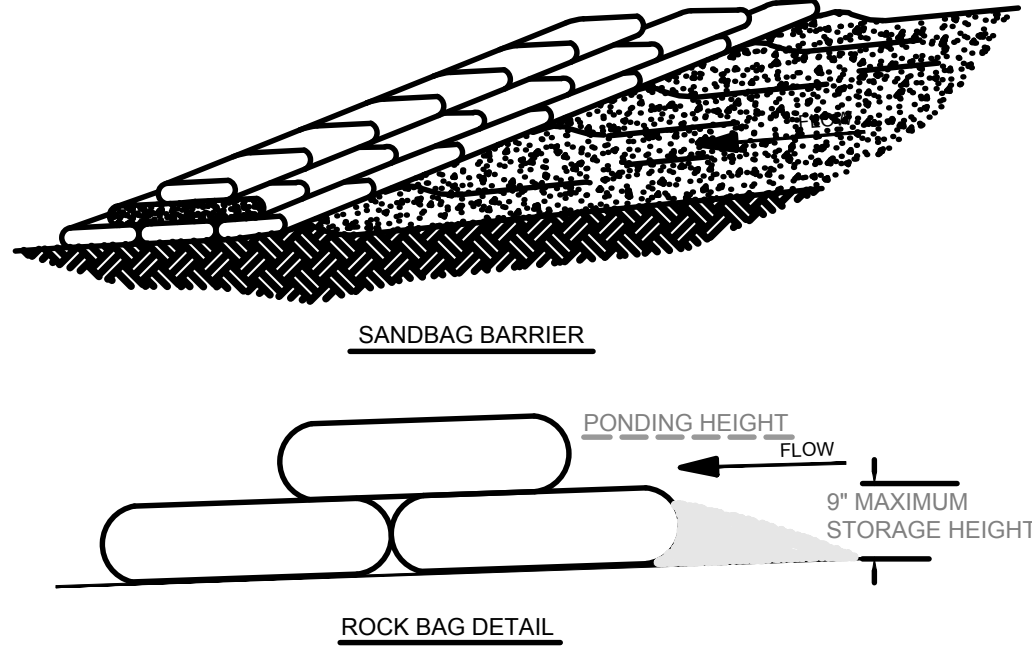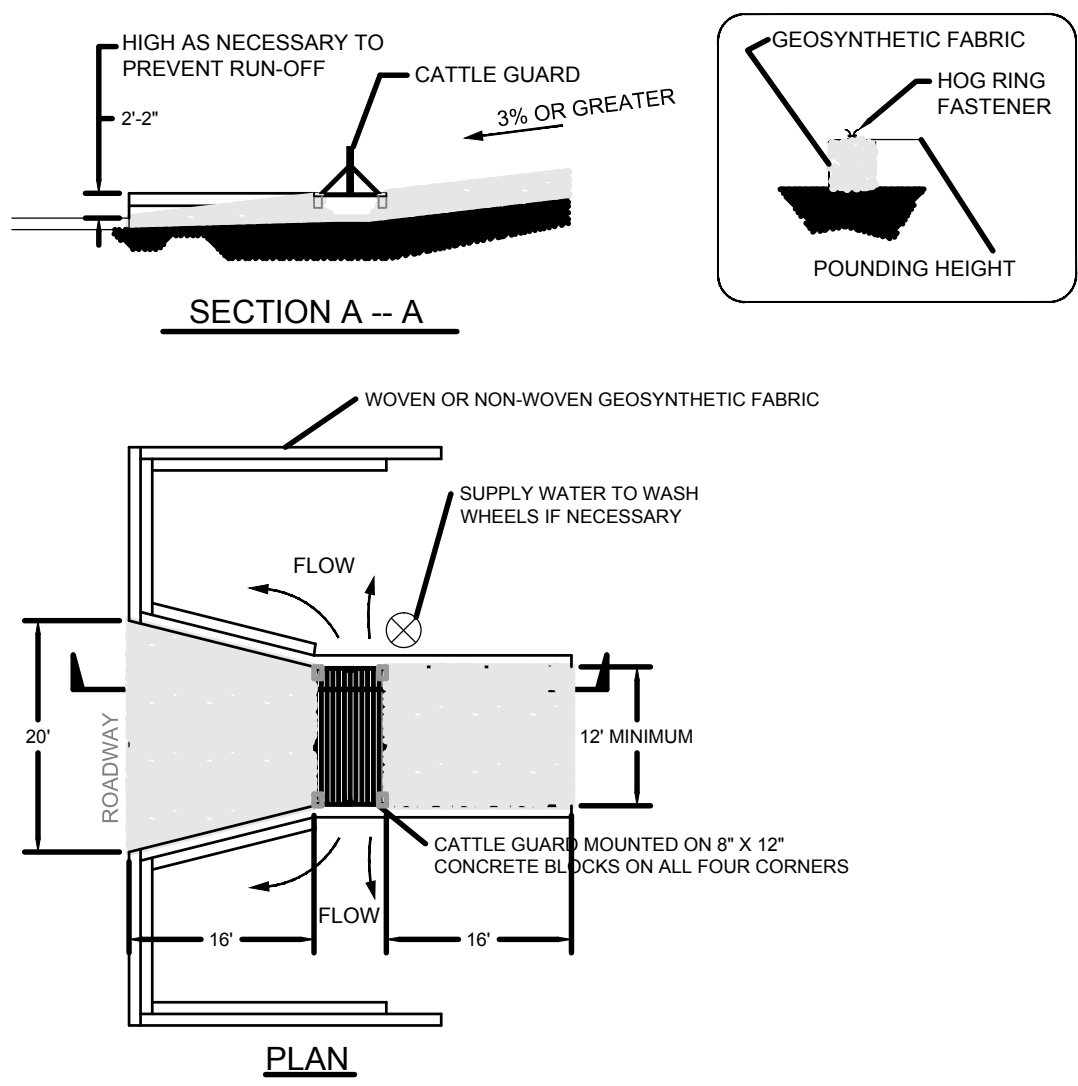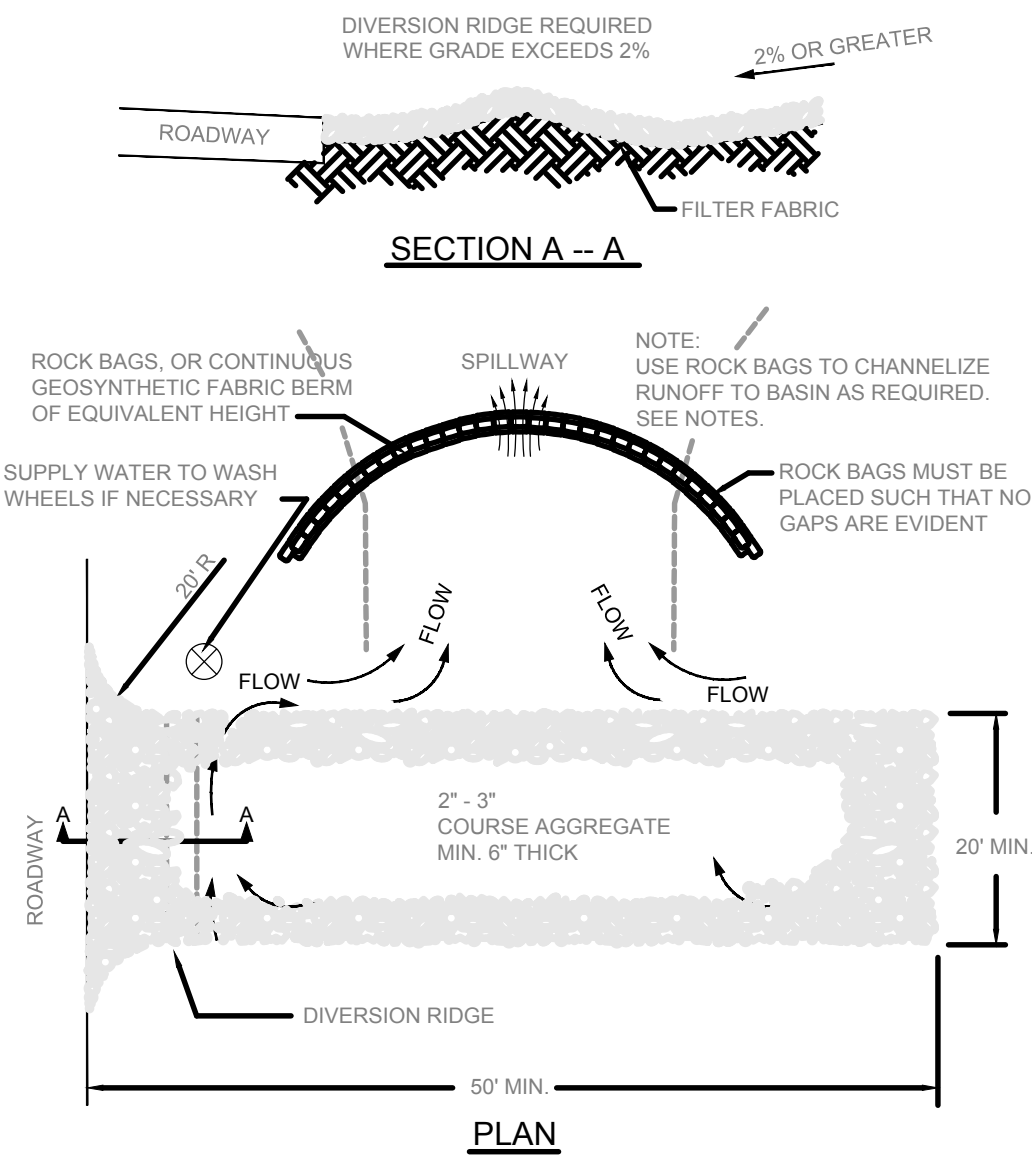

- NOTES:
1. A "REASONABLE" DESIGN SIZE PARTICLE MUST BE SELECTED.
 2. SIZE DISTRIBUTION OR UPSTREAM SOIL PARTICLES MUST BE EVALUATED.
 3. INFLOW AND OUTFLOW FROM THE SYSTEM FOR A SPECIFIC FREQUENCY STORM MUST BE KNOWN.
 4. POND VOLUME IS DIRECTLY PROPORTIONAL TO THE DISCHARGE RATE OF THE SYSTEM.
 5. POND VOLUME IS INVERSELY PROPORTIONAL TO THE MASS OF THE DESIGN PARTICLES.
 6. A SYSTEM MUST PROVIDE SUFFICIENT FLOW TO ALLOW FOR DEPOSITION OF DESIGN PARTICLES.
 7. THE PONDING HEIGHT MUST BE WELL BELOW THE GROUND ELEVATION DOWNSLOPE TO PREVENT RUNOFF FROM BYPASSING THE INLET. A TEMPORARY DIKE MAY BE NECESSARY ON THE DOWNSLOPE SIDE OF THE STRUCTURE.
 8. ROCK BAG SILT BARRIER SHALL BE PLACED ON SLOPE CONTOURS TO MAXIMIZE PONDING EFFICIENCY.
 9. PLACE ROCK BAG SUCH THAT NO GAPS ARE EVIDENT.
 10. INSPECT AND REPAIR FENCE AFTER EACH STORM EVENT AND REMOVE SEDIMENT WHEN NECESSARY. 9" MAXIMUM RECOMMENDED STORAGE HEIGHT.
 11. REMOVED SEDIMENT SHALL BE DEPOSITED TO AN AREA THAT WILL NOT CONTRIBUTE TO SEDIMENT OFF-SITE AND CAN BE PERMANENTLY STABILIZED.

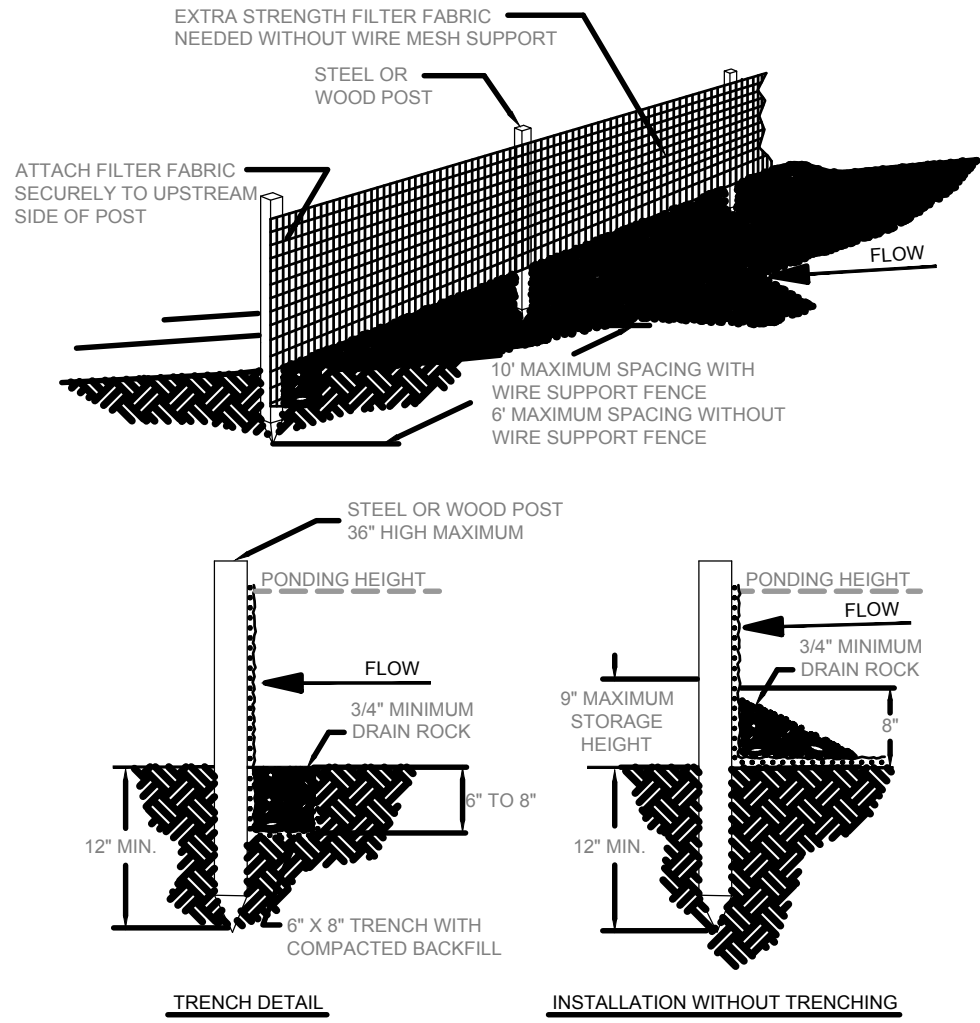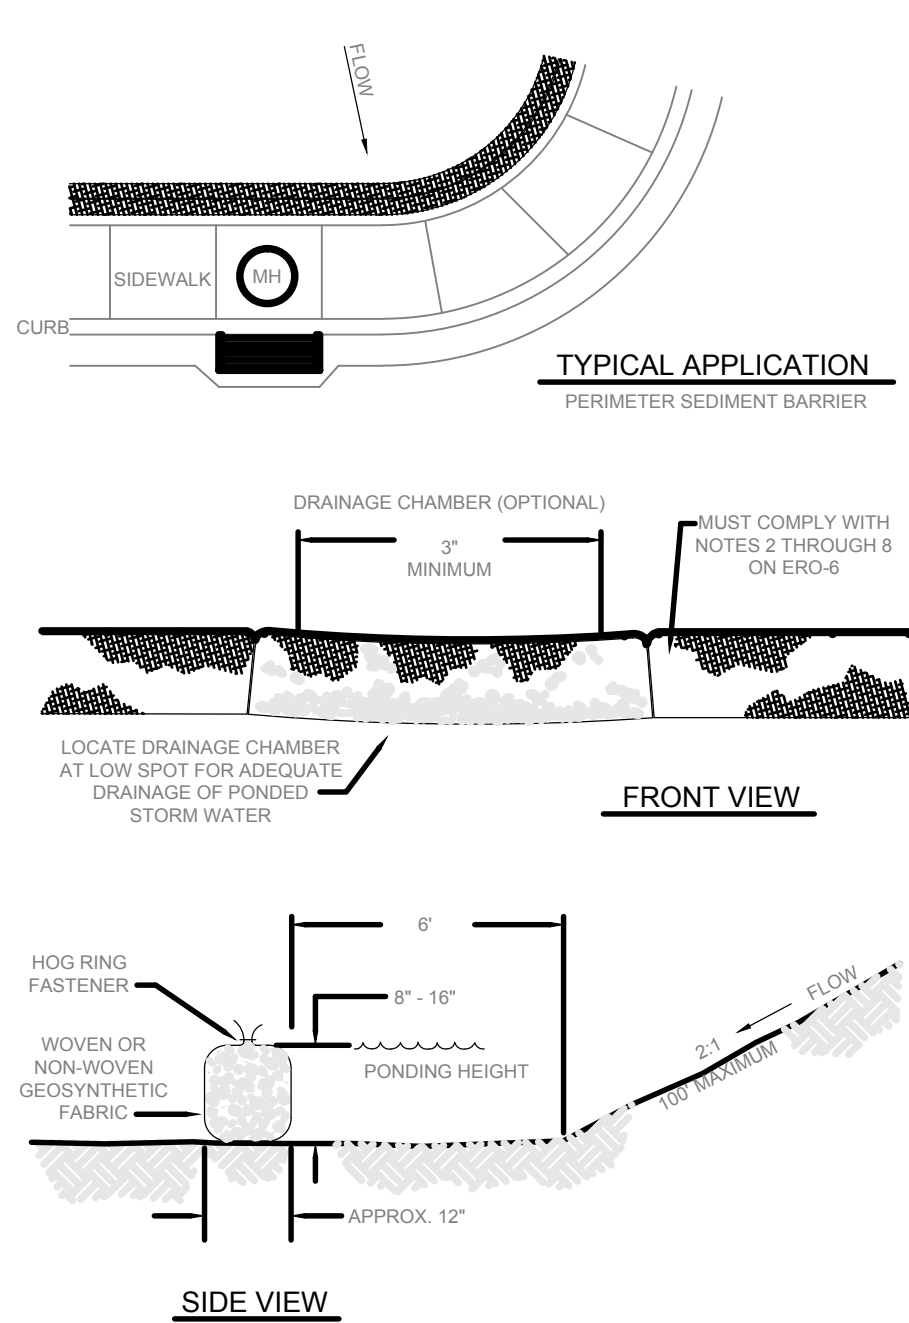






TEMPORARY GRAVEL CONSTRUCTION ENTRANCE / EXIT

TEMPORARY GRAVEL CONSTRUCTION ENTRANCE / EXIT FOR STEEP GRADES

ROCK BAG SILT FENCE

CONTINUOUS SILT FENCE

FILTER FABRIC SILT FENCE

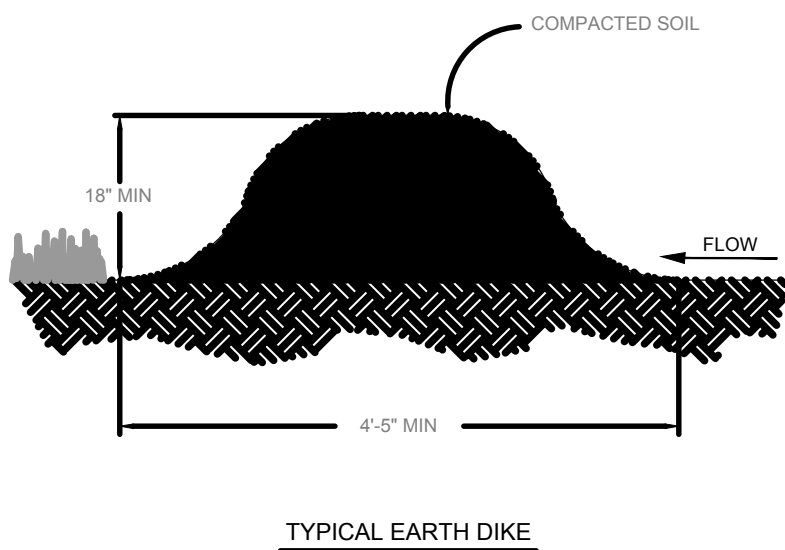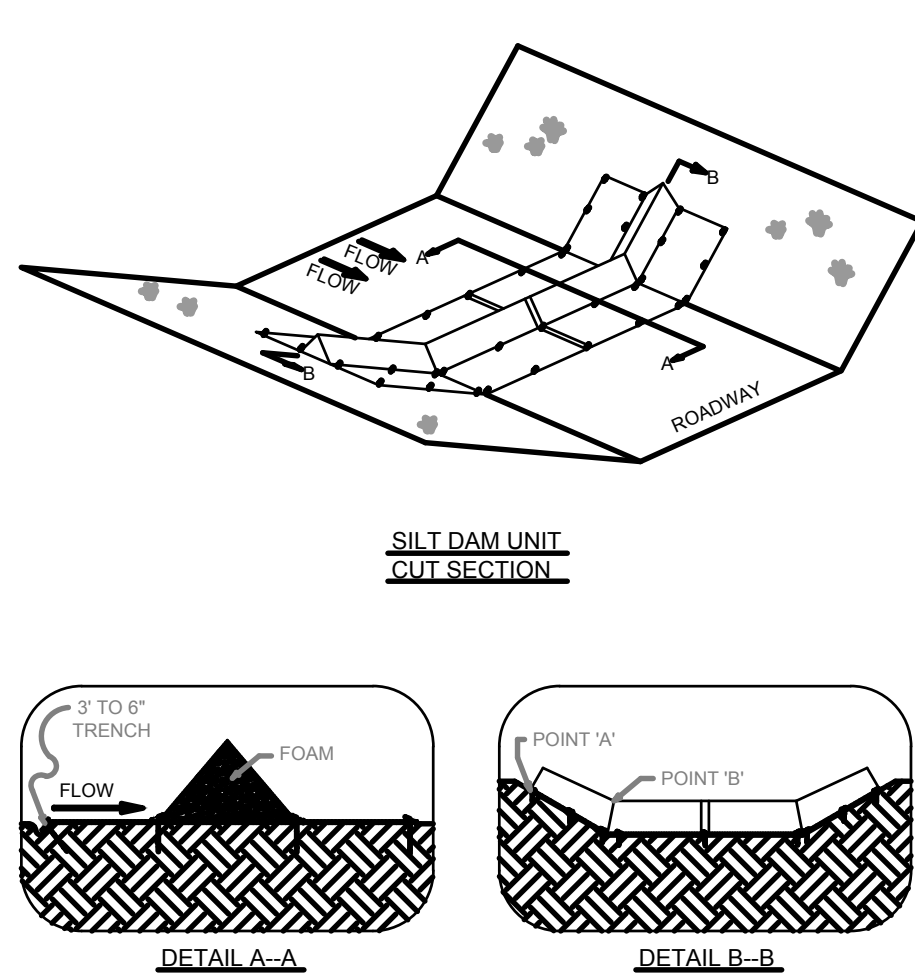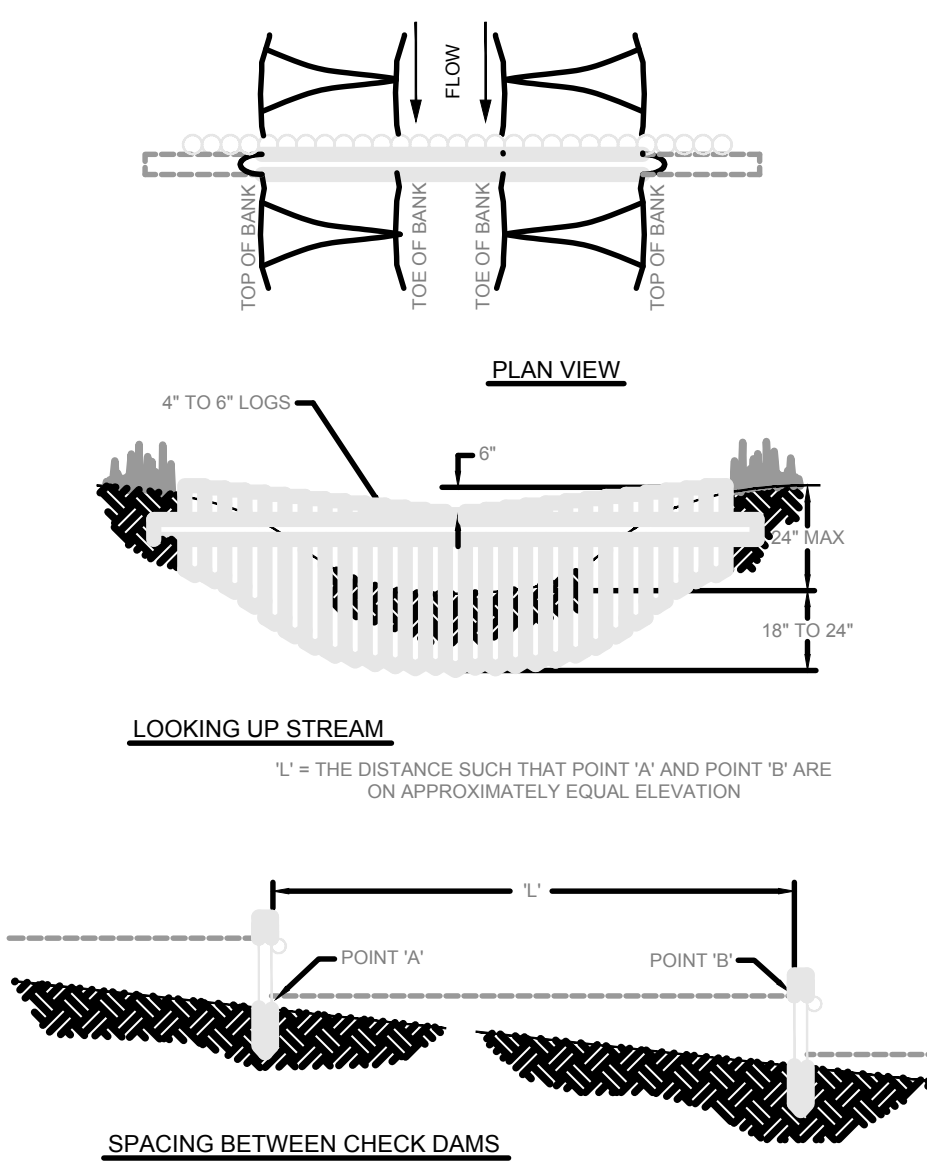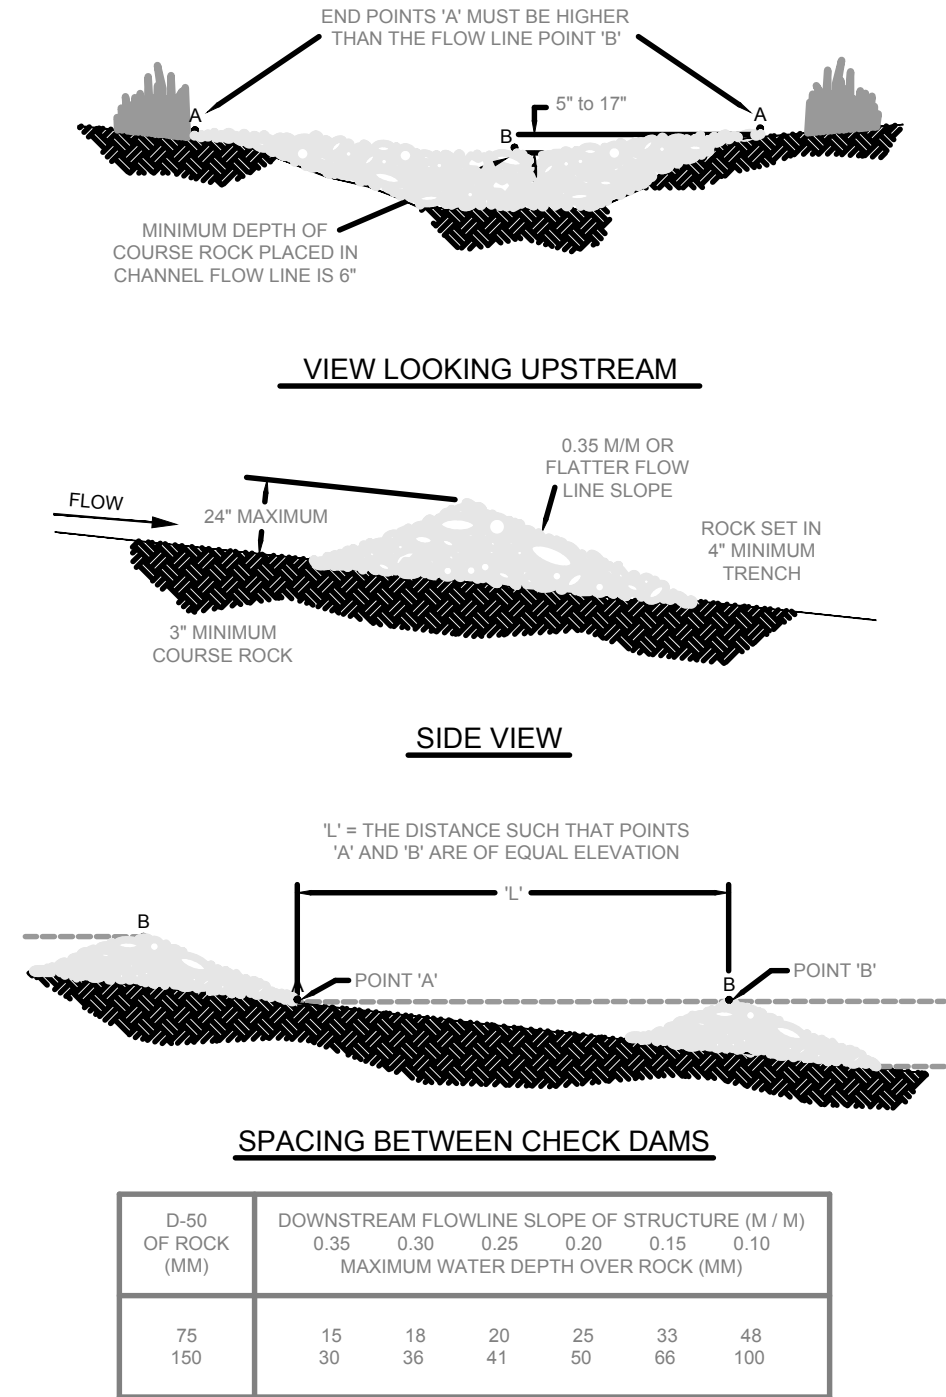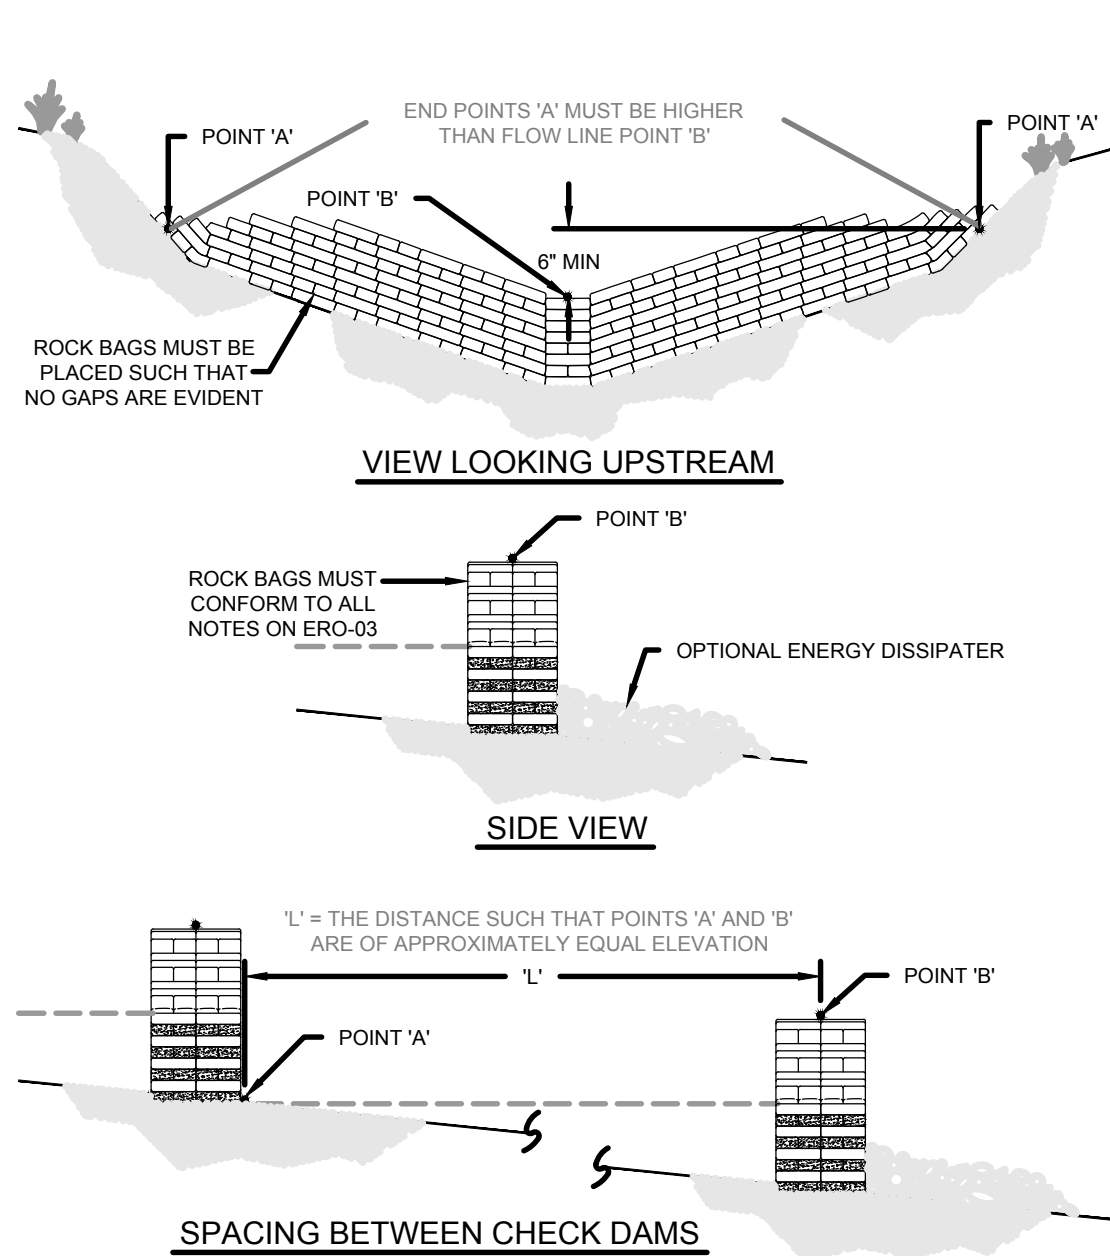

ROCK BAG CHECK DAMS

ROCK CHECK DAMS


LOG CHECK DAM

EROSION BLANKETS & TURF REINFORCEMENT MATS SILT DAM INSTALLATION

OKLAHOMA CITY
PUBLIC WORKS DEPARTMENT
ENGINEERING DIVISION

EROSION CONTROL STANDARDS


APPROVED BY:  DATE: **2-16-01** DRAWN: V.S.C. DATE: 02/14/01 DWG. NO. ERO-D1

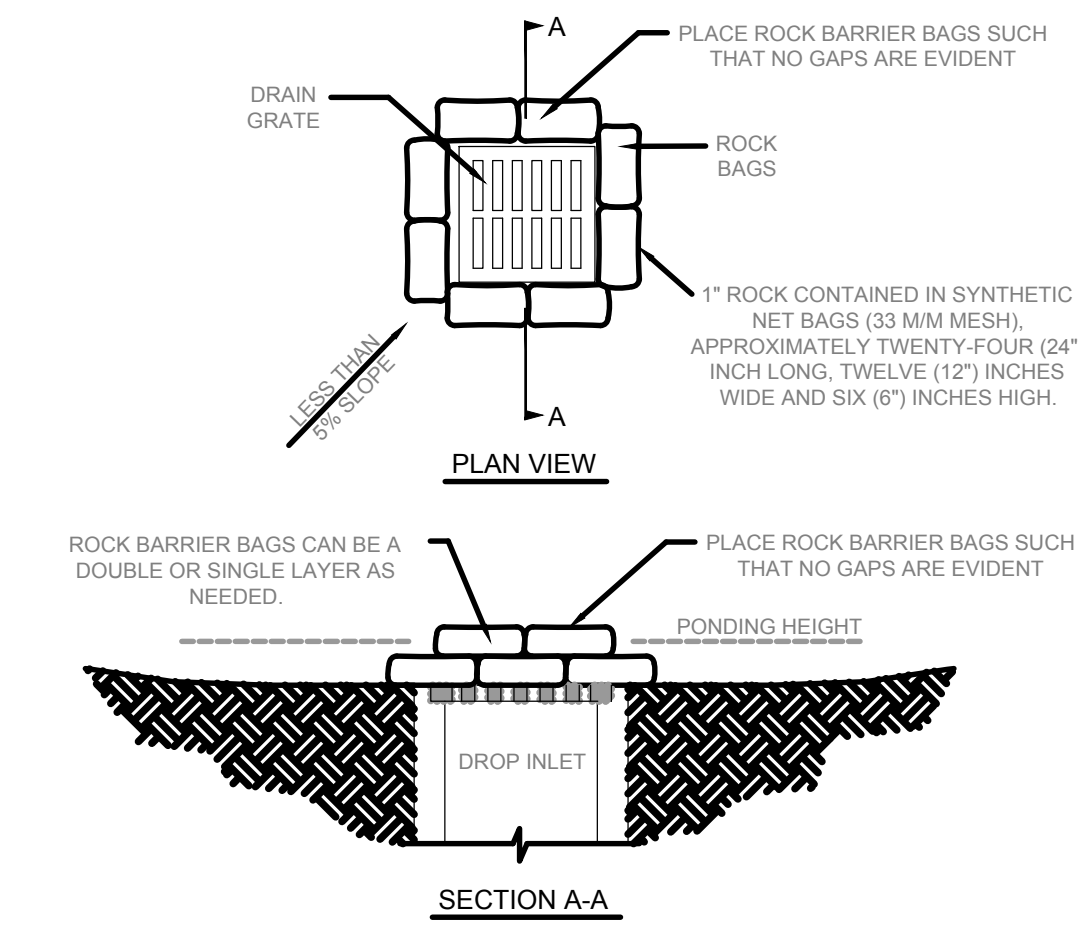

NOTES:

1. DROP INLET SEDIMENT BARRIERS ARE TO BE USED FOR SMALL, NEARLY LEVEL DRAINAGE AREAS. (LESS THAN 5%.)
2. A "REASONABLE" DESIGN SIZE PARTICLE TO CAPTURE MUST BE SELECTED.
3. SIZE DISTRIBUTION OF UPSTREAM SOIL PARTICLES MUST BE EVALUATED.
4. INFLOW AND OUTFLOW FROM THE SYSTEM FOR A SPECIFIC FREQUENCY STORM MUST BE KNOWN.
5. POND VOLUME IS DIRECTLY PROPORTIONAL TO THE DISCHARGE RATE OF WATER FROM THE SYSTEM.
6. POND VOLUME IS INVERSELY PROPORTIONAL TO THE MASS OF THE DESIGN SIZE SUSPENDED PARTICLE.
7. A SYSTEM MUST PROVIDE SUFFICIENT FLOW TO ALLOW FOR DEPOSITION OF DESIGN SIZE PARTICLES.
8. THE PONDING HEIGHT MUST BE WELL BELOW THE GROUND ELEVATION DOWNSLOPE TO PREVENT RUNOFF FROM BYPASSING THE INLET. A TEMPORARY DIKE MAY BE NECESSARY ON THE DOWNSLOPE SIDE OF THE STRUCTURE.


ROCK BAG DROP INLET SEDIMENT BARRIER

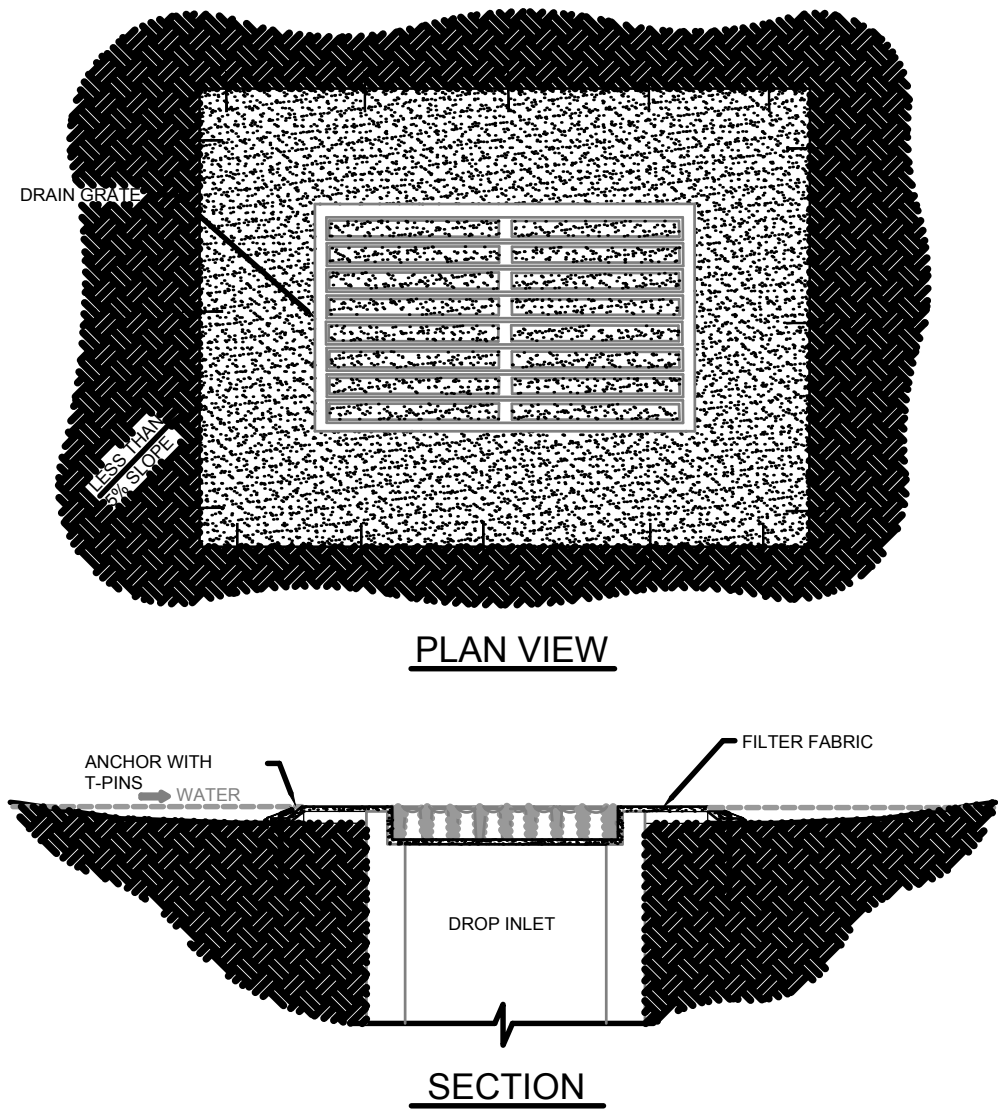

NOTE:

1. DROP INLET SEDIMENT BARRIERS ARE TO BE USED FOR SMALL, NEARLY LEVEL DRAINAGE AREAS. (LESS THAN 5%)
2. USE T-PINS TO ANCHOR FIBER MAT INTO THE SOIL.


FILTER MAT DROP INLET SEDIMENT BARRIER

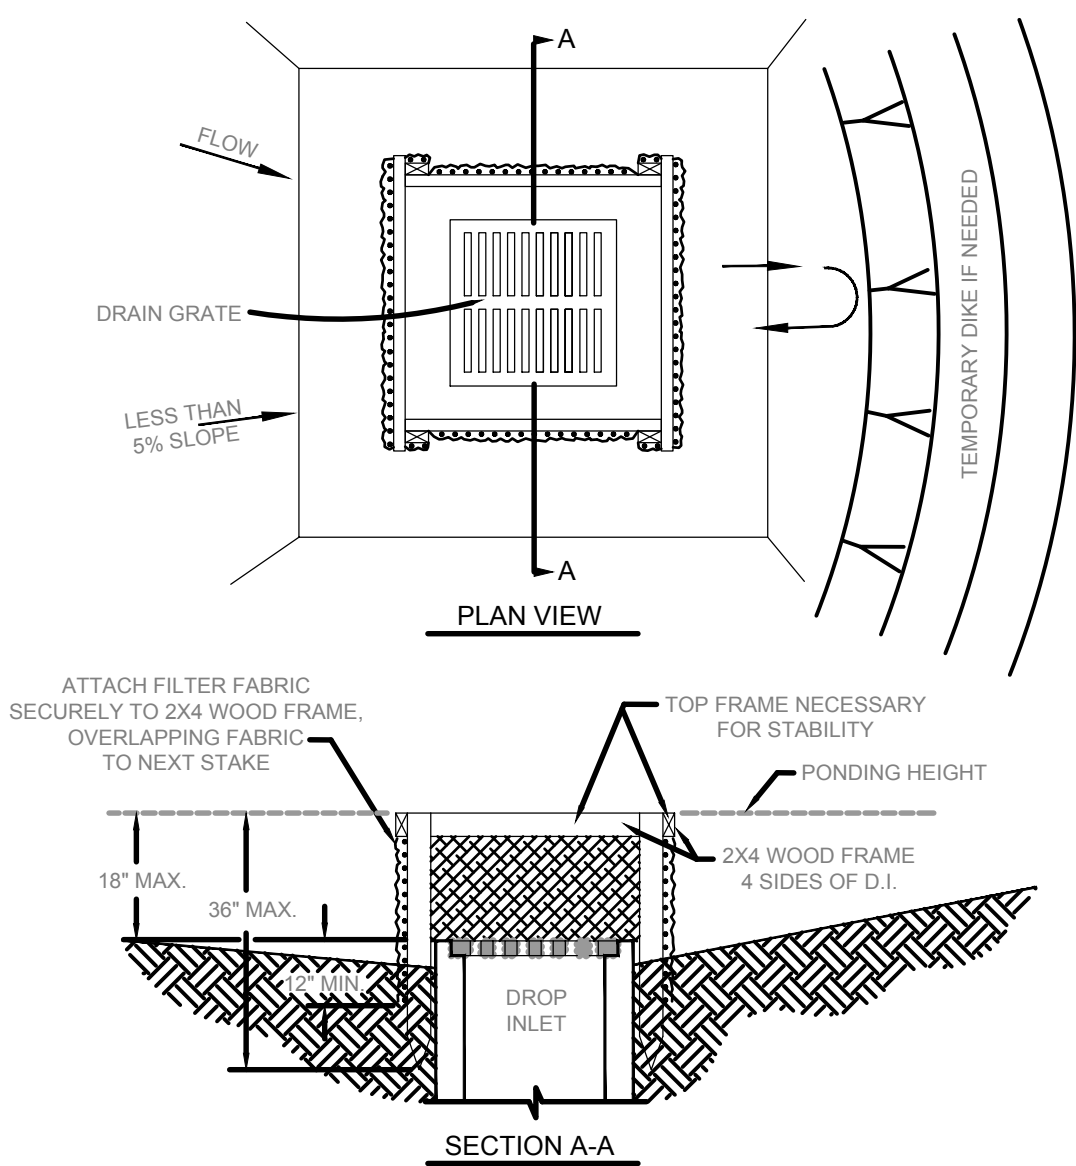

NOTES:

1. DROP INLET SEDIMENT BARRIERS ARE TO BE USED FOR SMALL, NEARLY LEVEL DRAINAGE AREAS. (LESS THAN 5%)
2. USE 2X4 WOOD OR EQUIVALENT METAL STAKES, 3' MINIMUM LENGTH.
3. INSTALL 2X4 WOOD TOP FRAME TO INSURE STABILITY.
4. THE TOP OF THE FRAME (PONDING HEIGHT), MUST BE WELL BELOW THE GROUND ELEVATION DOWNSLOPE TO PREVENT RUNOFF FROM BY-PASSING THE INLET. A TEMPORARY DIKE MAY BE NECESSARY ON THE DOWNSLOPE SIDE OF THE STRUCTURE.


SILT FENCE DROP INLET SEDIMENT BARRIER

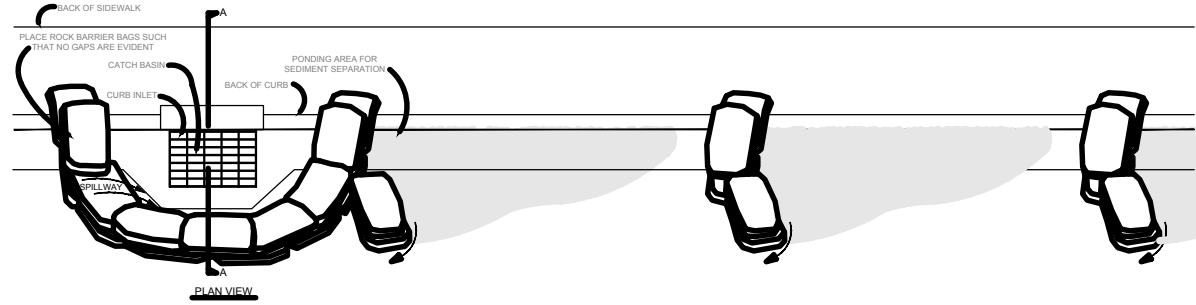

NOTES:

1. A 'REASONABLE' DESIGN SIZE PARTICLE TO CAPTURE MUST BE SELECTED.
2. SIZE DISTRIBUTION OF UP STREAM SOIL PARTICLES MUST BE EVALUATED.
3. INFLOW AND OUTFLOW FROM THE SYSTEM FOR A SPECIFIC FREQUENCY STORM MUST BE KNOWN.
4. POND VOLUME IS DIRECTLY PROPORTIONAL TO THE DISCHARGE RATE OF WATER FROM SYSTEM.
5. POND VOLUME IS INVERSELY PROPORTIONAL TO THE MASS OF THE DESIGN SIZE SUSPENDED PARTICLE.
6. A SYSTEM MUST PROVIDE SUFFICIENT FLOW TO ALLOW FOR DEPOSITION OF DESIGN PARTICLES.
7. THE PONDING HEIGHT MUST BE BELOW THE GROUND ELEVATION DOWNSLOPE TO PREVENT RUNOFF FROM BYPASSING THE INLET. A TEMPORARY DIKE MAY BE NECESSARY ON THE DOWNSIDE OF THE STRUCTURE.
8. PLACE CURB TYPE ROCK BAG BARRIER WITH EXTRA FLOW BARRIERS ON STREET WHERE FLOW IS HEAVIER, PLACE AS MANY AS NEEDED.
9. BAGS OF WOVEN GEOTEXTILE FABRIC, FILLED WITH GRAVEL MUST BE LAYERED SUCH THAT NO GAPS ARE EVIDENT.
10. LEAVE ONE SANDBAG GAP IN THE TOP ROW ON THE SIDE AWAY FROM FLOW, TO PROVIDE A SPILLWAY; OR IN THE CENTER IF PONDING IS NEEDED ON BOTH SIDES.
11. INSPECT BARRIERS AND REMOVE SEDIMENT AFTER EACH STORM EVENT, SEDIMENT AND GRAVEL MUST BE REMOVED FROM THE TRAVELED WAY IMMEDIATELY


ROCKBAG INLET BARRIER WITH FLOW CHECK BARRIERS

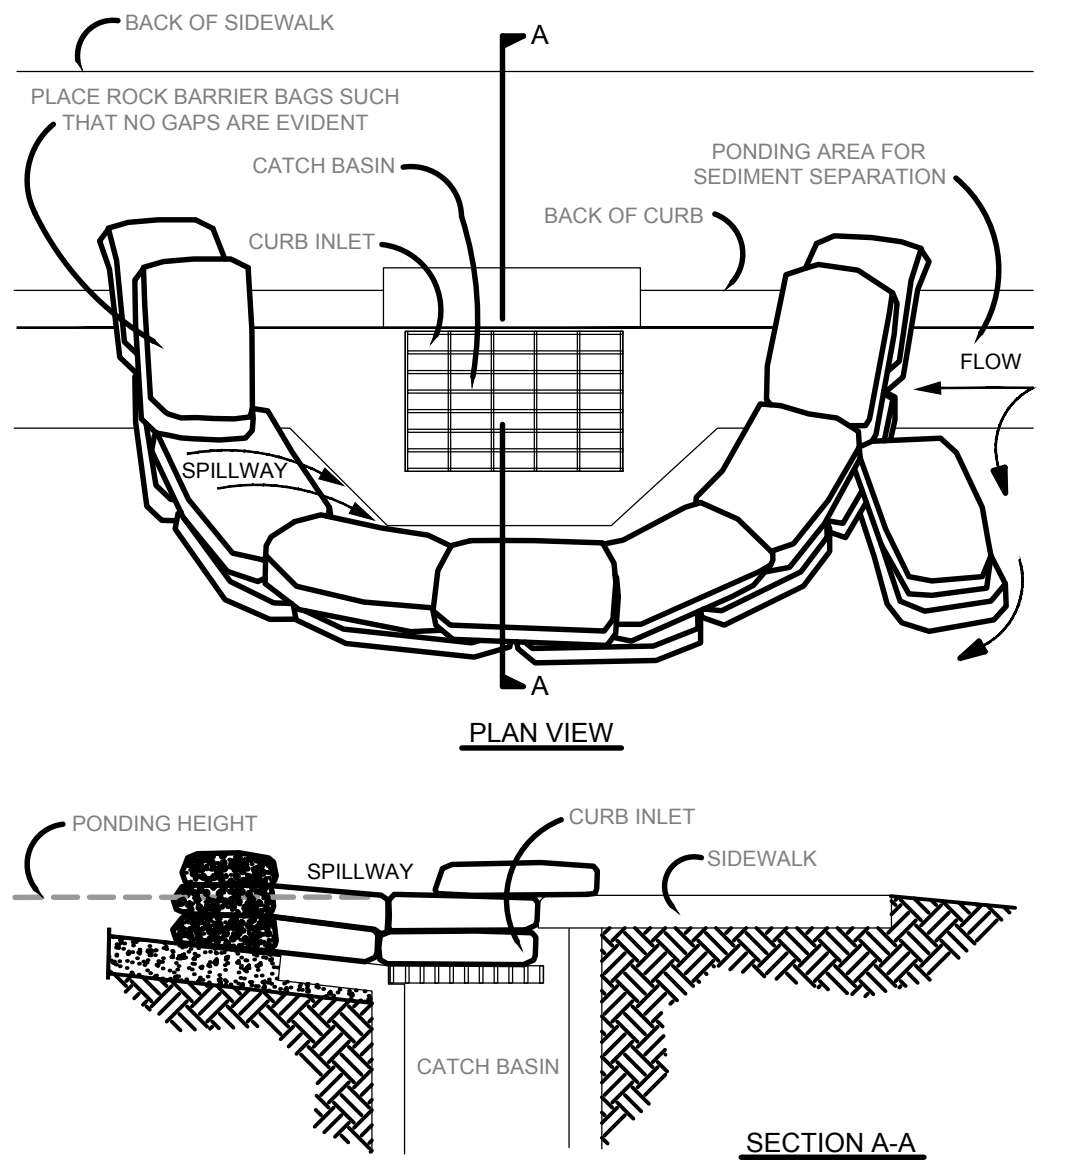

NOTES:

1. ALL ROCK BAG BARRIERS MUST AGREE WITH THE NOTES ON PREVIOUS PAGE.
2. PLACE CURB TYPE ROCK BAG BARRIER ON GENTLY SLOPING STREET, WHERE WATER CAN POND AND ALLOW SEDIMENT TO SEPARATE FROM RUNOFF.
3. BAGS OF WOVEN GEOTEXTILE FABRIC, FILLED WITH GRAVEL MUST BE LAYERED SUCH THAT NO GAPS ARE EVIDENT.
4. LEAVE ONE SANDBAG GAP IN THE TOP ROW ON THE SIDE AWAY FROM FLOW, TO PROVIDE A SPILLWAY; OR IN THE CENTER IF PONDING IS NEEDED ON BOTH SIDES.
5. INSPECT BARRIERS AND REMOVE SEDIMENT AFTER EACH STORM EVENT, SEDIMENT AND GRAVEL MUST BE REMOVED FROM THE TRAVELED WAY IMMEDIATELY


ROCK BAG CURB INLET BARRIER

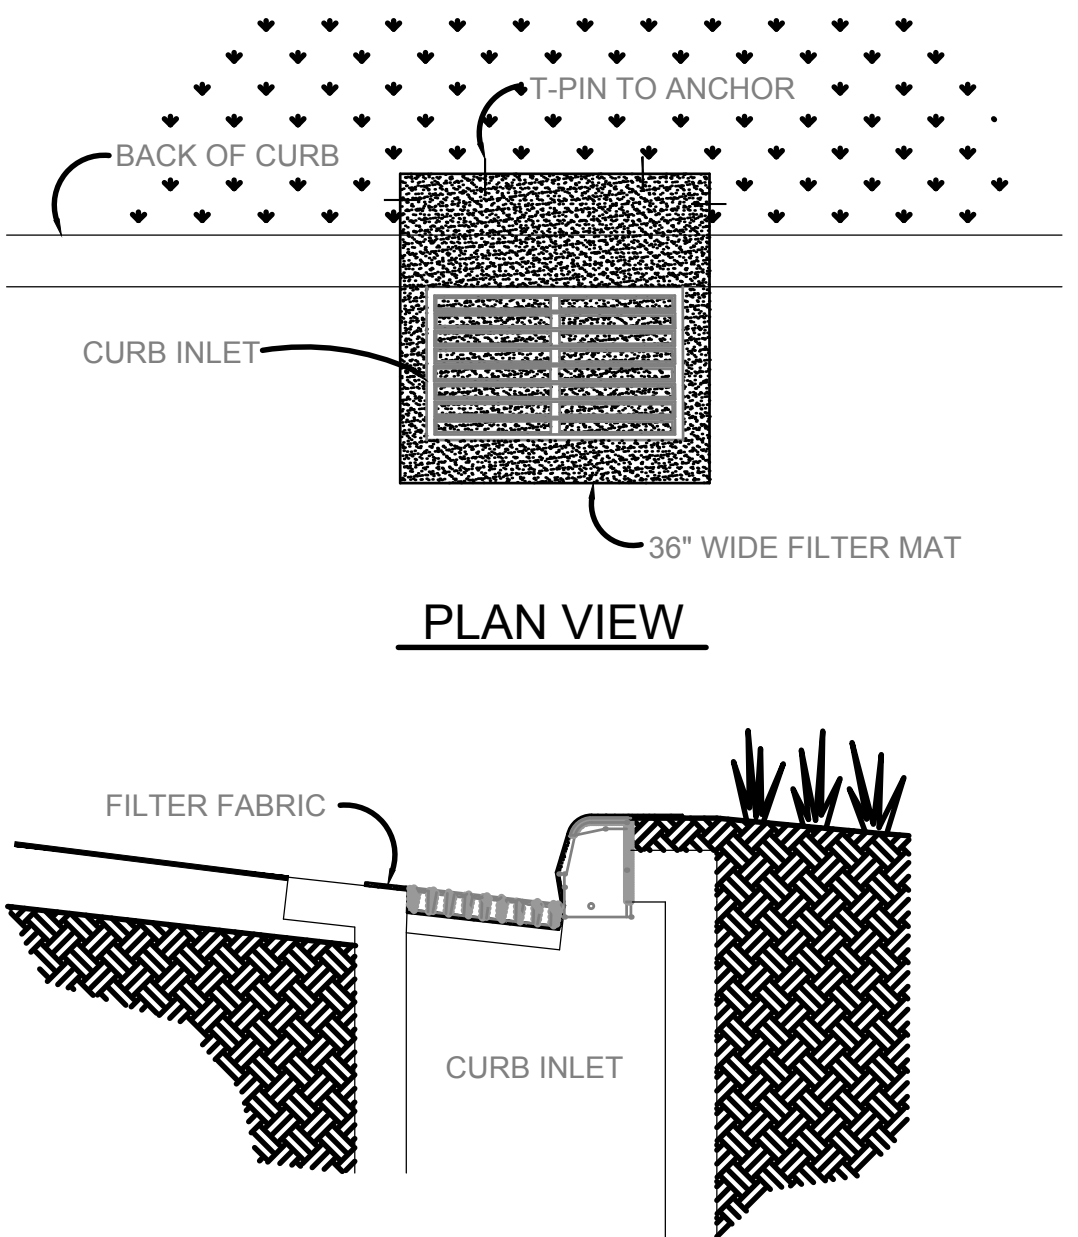

NOTES:

1. USE FILTER MAT SEDIMENT BARRIER WHEN CURB INLET IS LOCATED IN GENTLY SLOPING STREET, WITH MINIMAL NEED, WHERE WATER CAN FILTER AND ALLOW SEDIMENT TO SEPARATE FROM RUNOFF.
2. BARRIER SHALL ALLOW FOR OVERFLOW FROM SEVERE STORM EVENT.
3. INSPECT BARRIERS AND REMOVE SEDIMENT AFTER EACH STORM EVENT. SEDIMENT MUST BE REMOVED FROM THE TRAVELED WAY IMMEDIATELY.


CURB INLET FILTER AMT SEDIMENT BARRIER

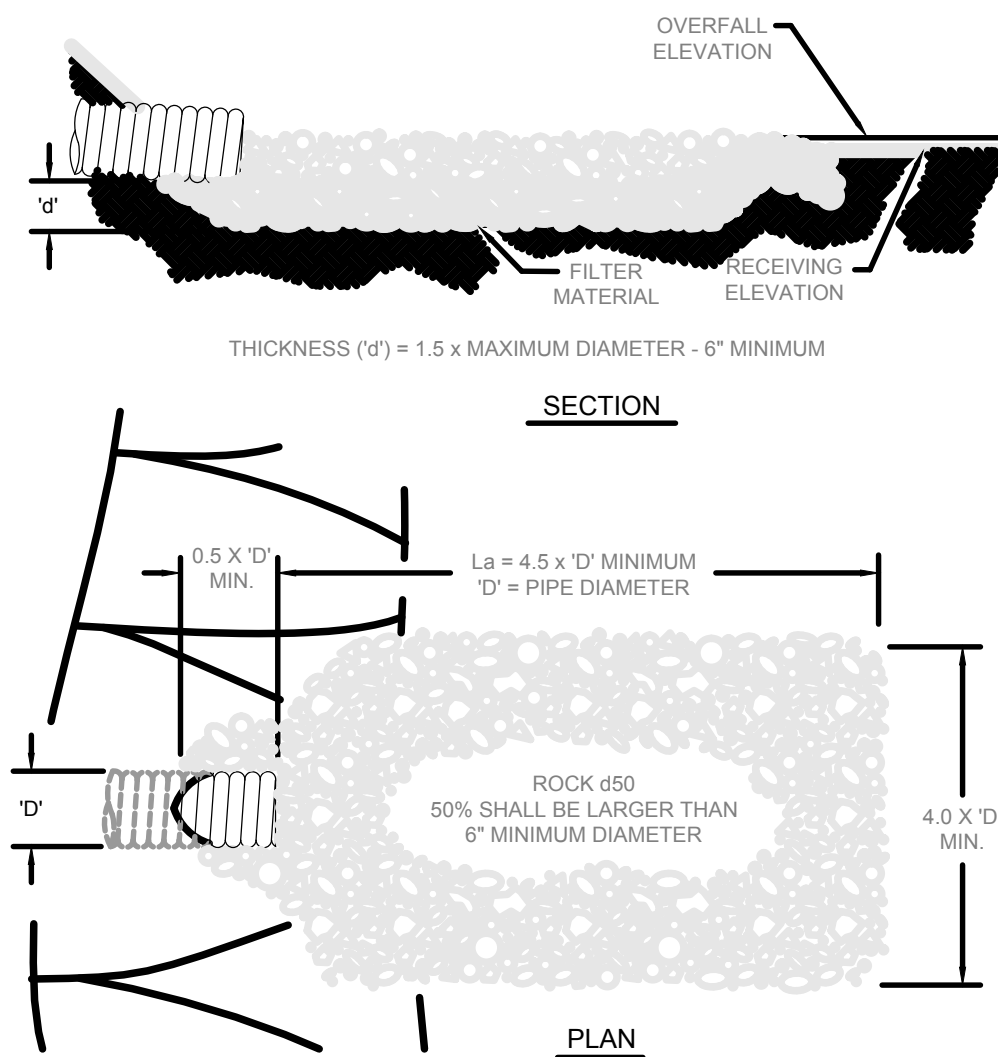


NOTES:

1. 'La' = LENGTH OF APRON. DISTANCE 'La' SHALL BE OF SUFFICIENT LENGTH TO DISSIPATE ENERGY.
2. APRON SHALL BE AT A ZERO GRADE AND ALIGNED STRAIGHT.
3. FILTER MATERIAL SHALL BE FILTER FABRIC OR 6\"/>


ENERGY DISSIPATER

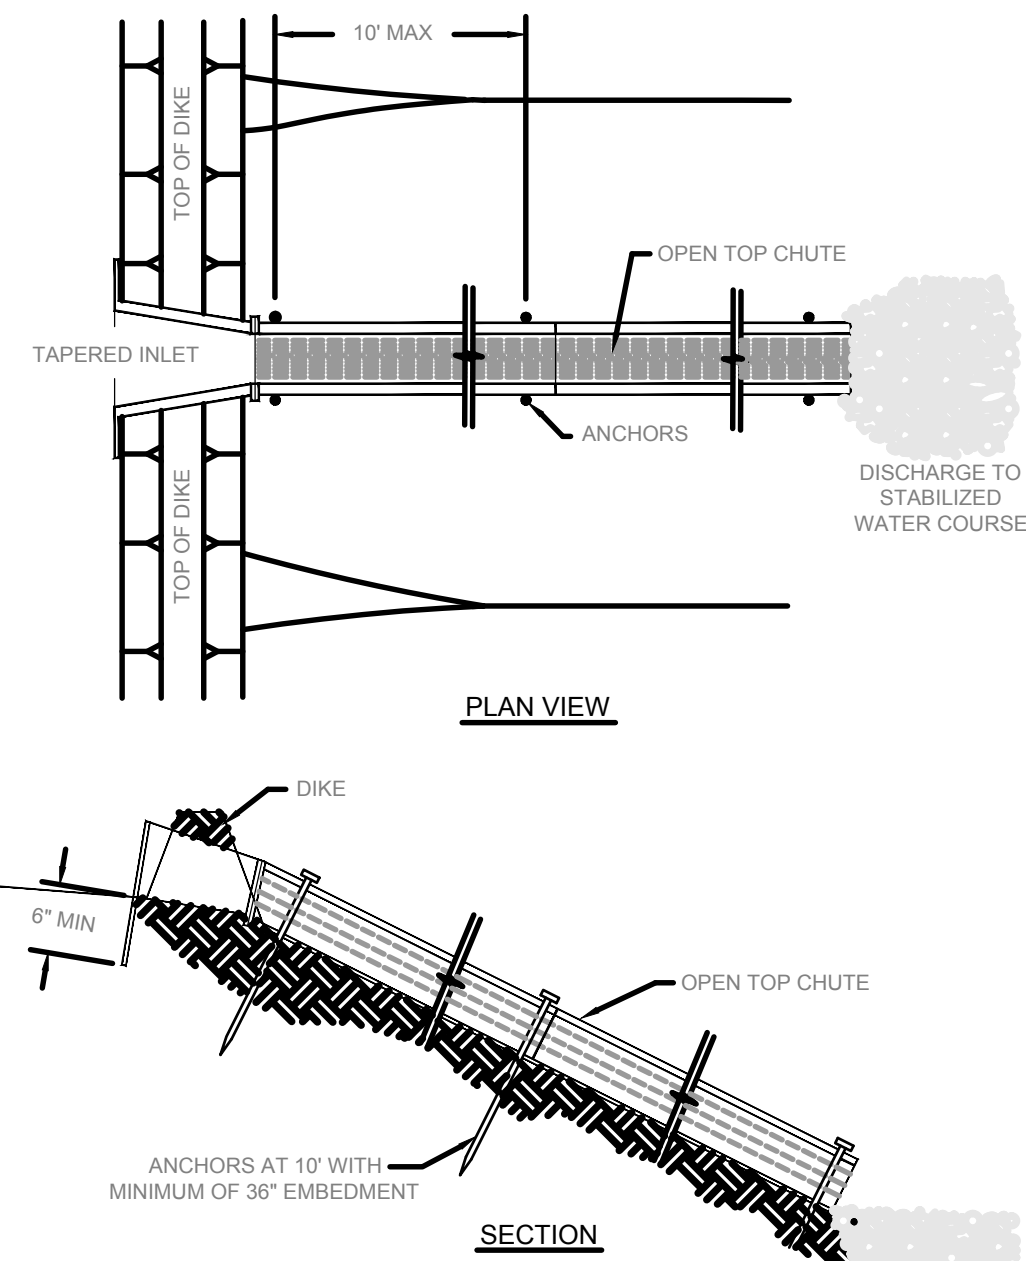

OVERSIDE DRAIN

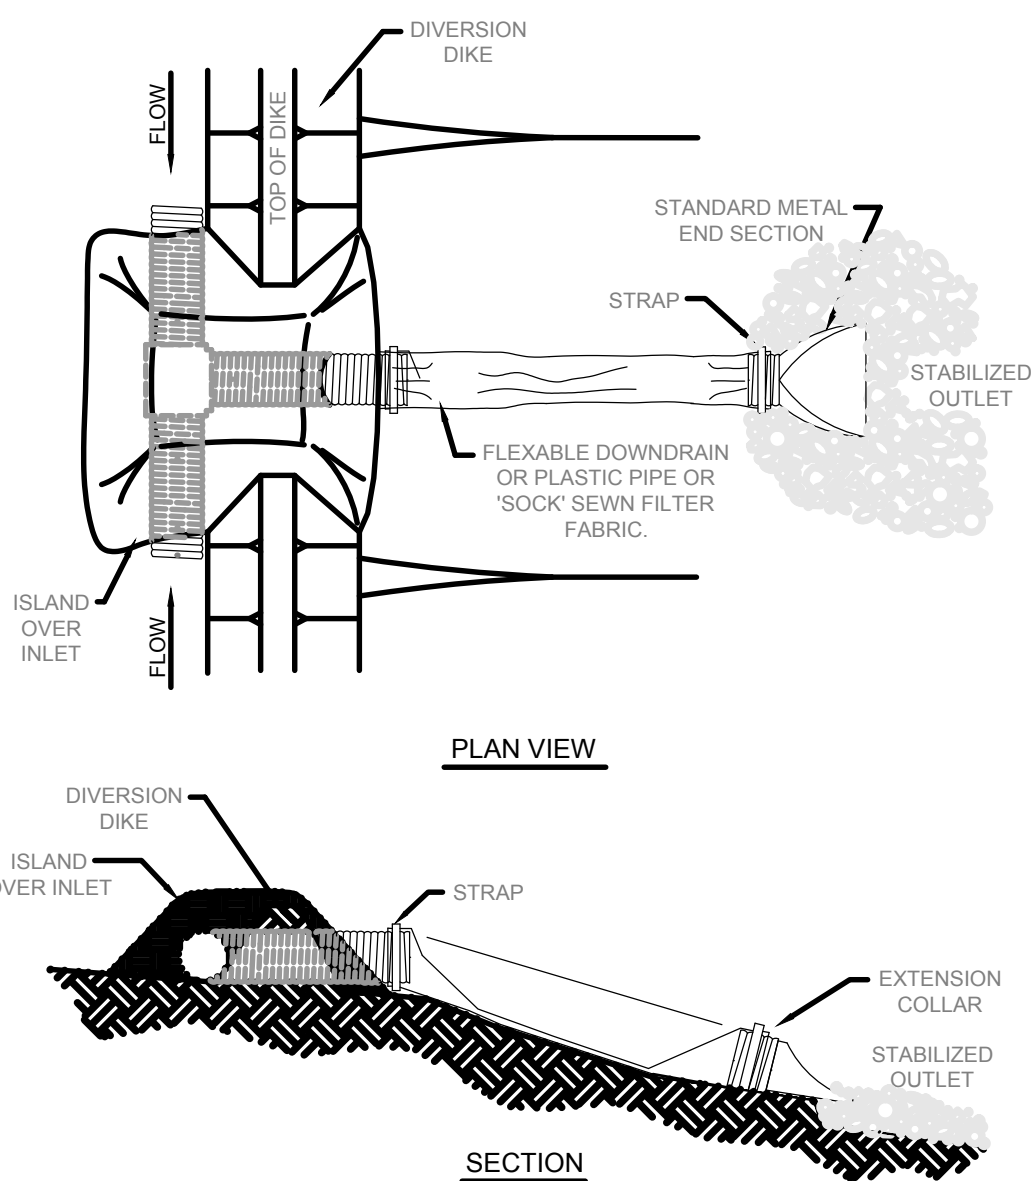

SLOPE DRAIN

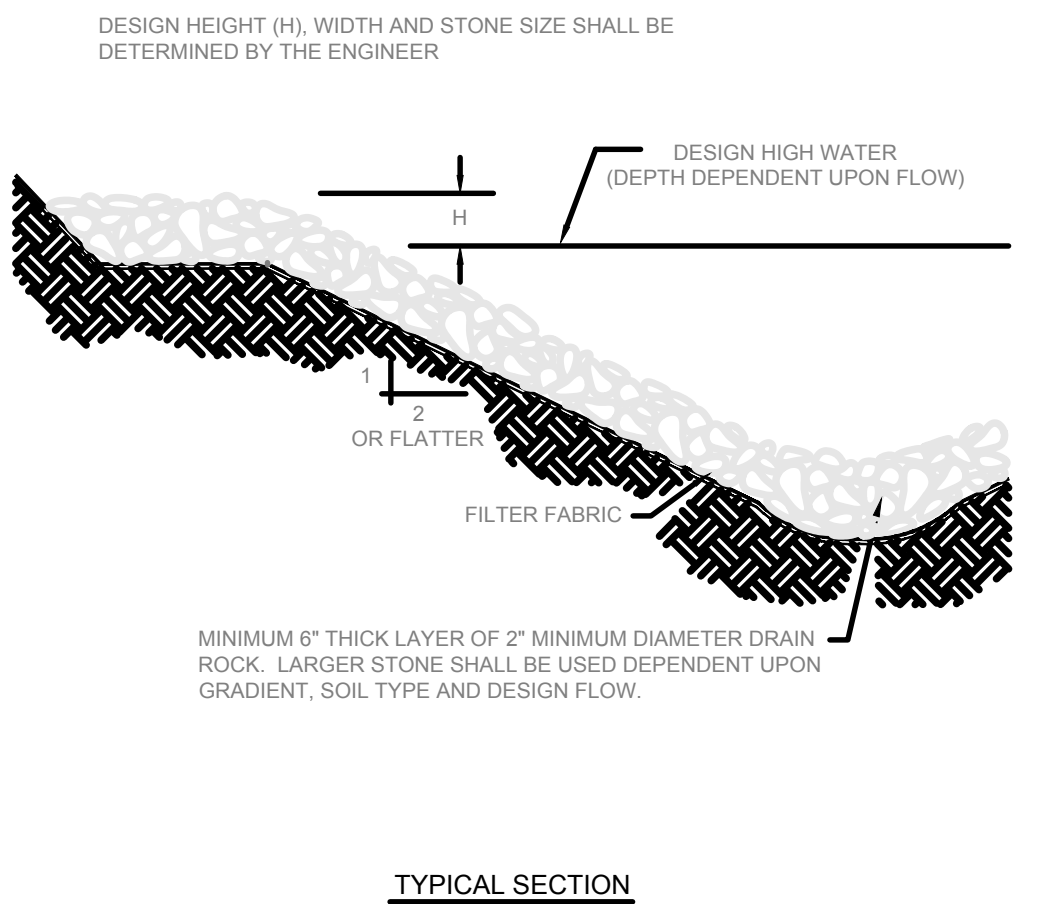

ROCK LINED CHANNEL

OKLAHOMA CITY
PUBLIC WORKS DEPARTMENT
ENGINEERING DIVISION

EROSION CONTROL STANDARDS

APPROVED BY:
PAUL J. BURM, P.E.
CITY ENGINEER

DATE: 2-16-01

DRAWN:
V.S.C.

DATE:
02/14/01

DWG. NO.
ERO-D2

STORM WATER MANAGEMENT EROSION AND SEDIMENT CONTROL NOTES

GENERAL NOTES

The following are requirements to be followed by the Contractor during all phases of the project. Please note that this construction will be accomplished under the provisions of the National Pollutant Discharge Elimination System (NPDES) of the U.S. Environmental Protection Agency (EPA). A Storm Water Pollution Prevention Plan (SWP3) must be prepared for this project in conformance with EPA regulations (Code of Federal Regulations (CFR) 40, Part 122) and Oklahoma Department of Environmental Quality (ODEQ) General Permit (OKR-10). The Contractor will be responsible for compliance with the OPDES permit and the SWP3, as well as with all provisions of the plans and specifications. It will also be the Contractor's responsibility to prevent soil or sediment loss from the construction site. The Contractor shall not leave the site until all erosion control, sediment control, and storm water management practices are in place; have been inspected and found satisfactory; and all temporary practices have been properly removed.

STORM WATER MANAGEMENT

The project must be designed to provide positive post-construction control of storm water runoff from the site [using gutters, curbs, inlets, piping, and outlets to the receiving stream]. The erosion and sediment control measures discussed below will also provide some temporary storm water controls. During the course of construction, the contractor will install and maintain storm water controls in the sequence specified herein to provide comprehensive management of storm water for a project of this nature.

EROSION AND SEDIMENT CONTROL


The project must be designed to minimize adverse off-site effects of soil erosion and resulting sediment loss through the use of proper construction techniques; and by installing both temporary and permanent management practices. All soil-disturbing activities performed by the Contractor will be accomplished in such manner as to prevent loss of sediment from the construction site during rainfall events. To accomplish this, the following specific steps will be taken during construction:




- 1 Immediately after mobilization but prior to initiation any soil-disturbing activities, the Contractor will install all specified perimeter controls on the site. These practices have been designed to trap all sediment produced during soil-disturbing activities, and to prevent off-site damage. It is recognized that some site preparation may be required to properly install these practices.
- 2 The recommended sequence for the installation and removal of erosion and sediment control measures is as follows: perimeter control measures (silt barriers and fencing) installed at designated areas; cleaning of street during construction; site grading (including temporary slope stabilization) as needed; installation of utilities; building construction; paving; final grading; installation of sod or vegetative materials; building construction; paving; final grading; installation of sod or vegetative materials; removal of temporary practices and perimeter controls; and site cleanup.
- 3 During all soil-disturbing activities, the Contractor will take appropriate steps using accepted construction methods to minimize exposure of unprotected soil and other construction materials to rainfall. Particular care must be exercised when dealing with topsoil stockpiles, fill material, or soil on slopes. The Contractor will maintain a date log of all soil disturbance activities or major grading operations, and of all management practice or control measure installations.

- 4 If, during the course of construction, any area of soil (including stockpiles) remains exposed for more than fourteen calendar days without suitable erosion control, then temporary stabilization measures should be installed unless soil-disturbing activities are planned on such areas within an additional seven calendar days. Suitable temporary stabilization measures are perimeter controls and silt barriers (such as rock bags, sand bags, and silt fencing) along all side-slope and down-slope borders of the disturbed area. Note that perimeter controls alone may not be successful; movement of large amounts of sediment produced by heavy rain on exposed soil could overwhelm such measures.
- 5 At the Contractor's discretion, additional temporary erosion control practices (such as rock bags, sand bag barriers, and silt fences) may be installed along any down-slope of side-slope perimeter of a soil-disturbed area to prevent sediment movement. Anchored erosion control matting, mulches, or other acceptable methods may also be installed to stabilize any unprotected slopes during construction, and hold them to the appropriate grade.

As site conditions warrant, the Contractor may also choose to modify the type or arrangement of specified practices to improve their effectiveness. As with any other project changes, the Contractor must present all proposed modifications to the Project Engineer for approval prior to installation.

- 6 The Contractor will inspect all specified practices at least once every fourteen calendar days, and after all rainfall events to insure that each specified practice remains intact. Any damage noted during such inspections shall be repaired promptly to restore the practice to original specifications. The Contractor will be responsible for maintenance of all erosion and sediment control practices as specified in the plans, including periodic regrading, and final grading after removal of all such practices.
- 7 When water is used for dust control or to promote vegetation, the Contractor will prevent the escape of this water and any sediment it may carry from the construction site.
- 8 Care must be exercised to prevent excessive off-site tracking of mud or sediment by construction vehicles. In addition to the specified gravel entrance, properly graveled transition areas should be established at all temporary site exits to assist in mud removal from departing vehicles. The Contractor shall be responsible for cleaning the street daily, or as directed by the City, when mud is tracked onto the street from the construction site.
- 9 During the site cleanup prior to the possession date, each temporary practice will be completely removed and the area finished to the appropriate post-project condition. This involves final grading, and installation of sod or grass seed on all bare soil areas. A minimum vegetation density of seventy percent, or an equivalent sediment stabilization measure (geotextiles, mulches, or gabions), is required until vegetation is established.

OKLAHOMA CITY PUBLIC WORKS DEPARTMENT ENGINEERING DIVISION			
STORM WATER EROSION AND SEDIMENT CONTROL PROCEDURES			
APPROVED BY  DENNIS CLOWERS, P.E. CITY ENGINEER	DATE 11/7/06	DRAWN: V.S.C.	DATE: 11/07/06
DWG. NO. D-010			

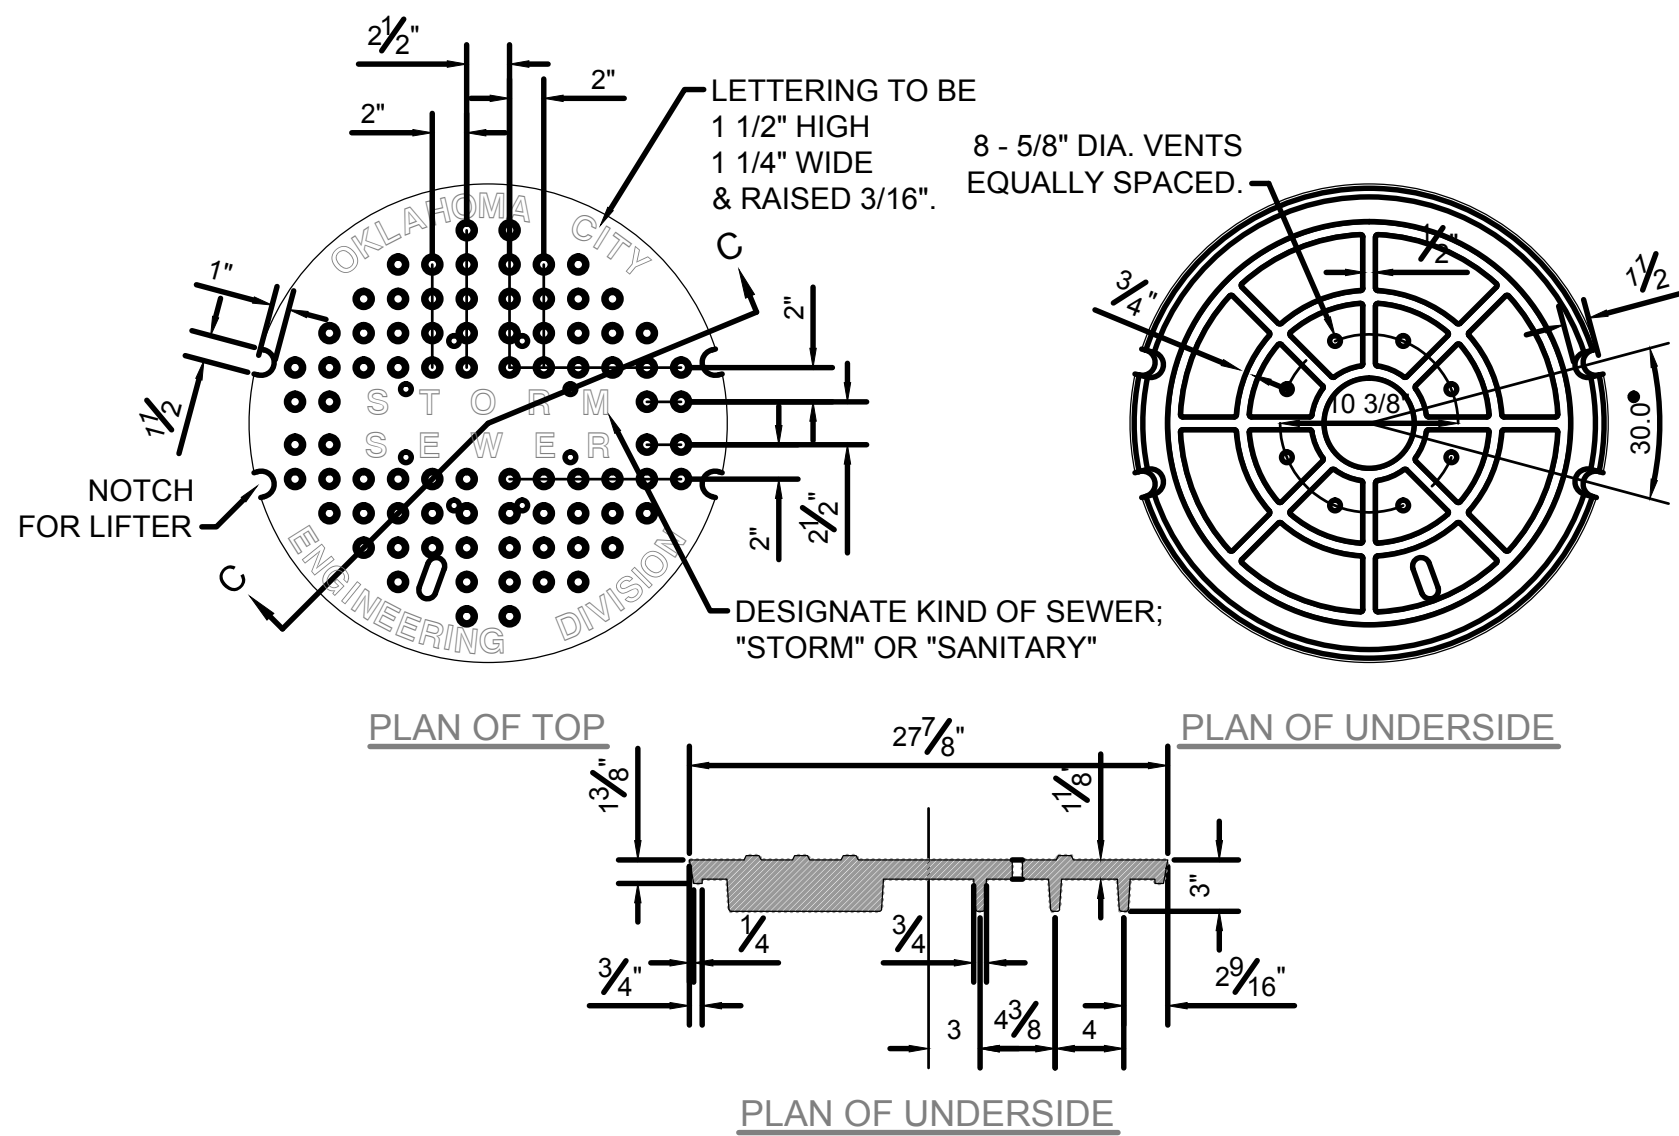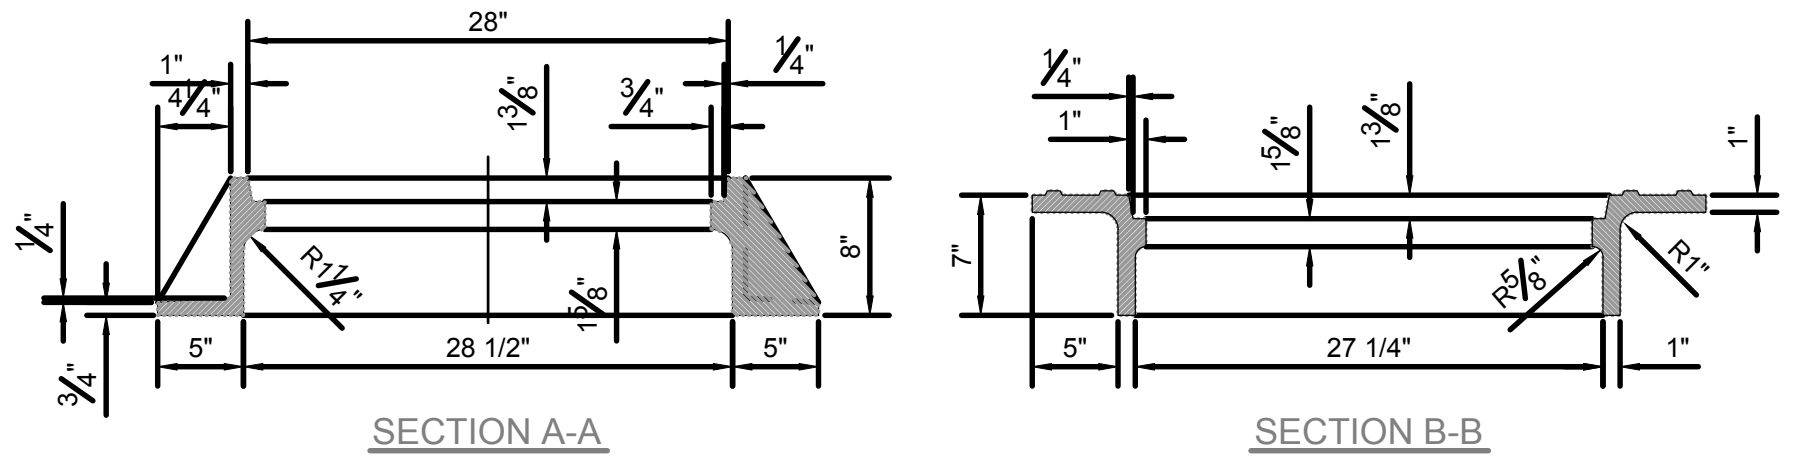
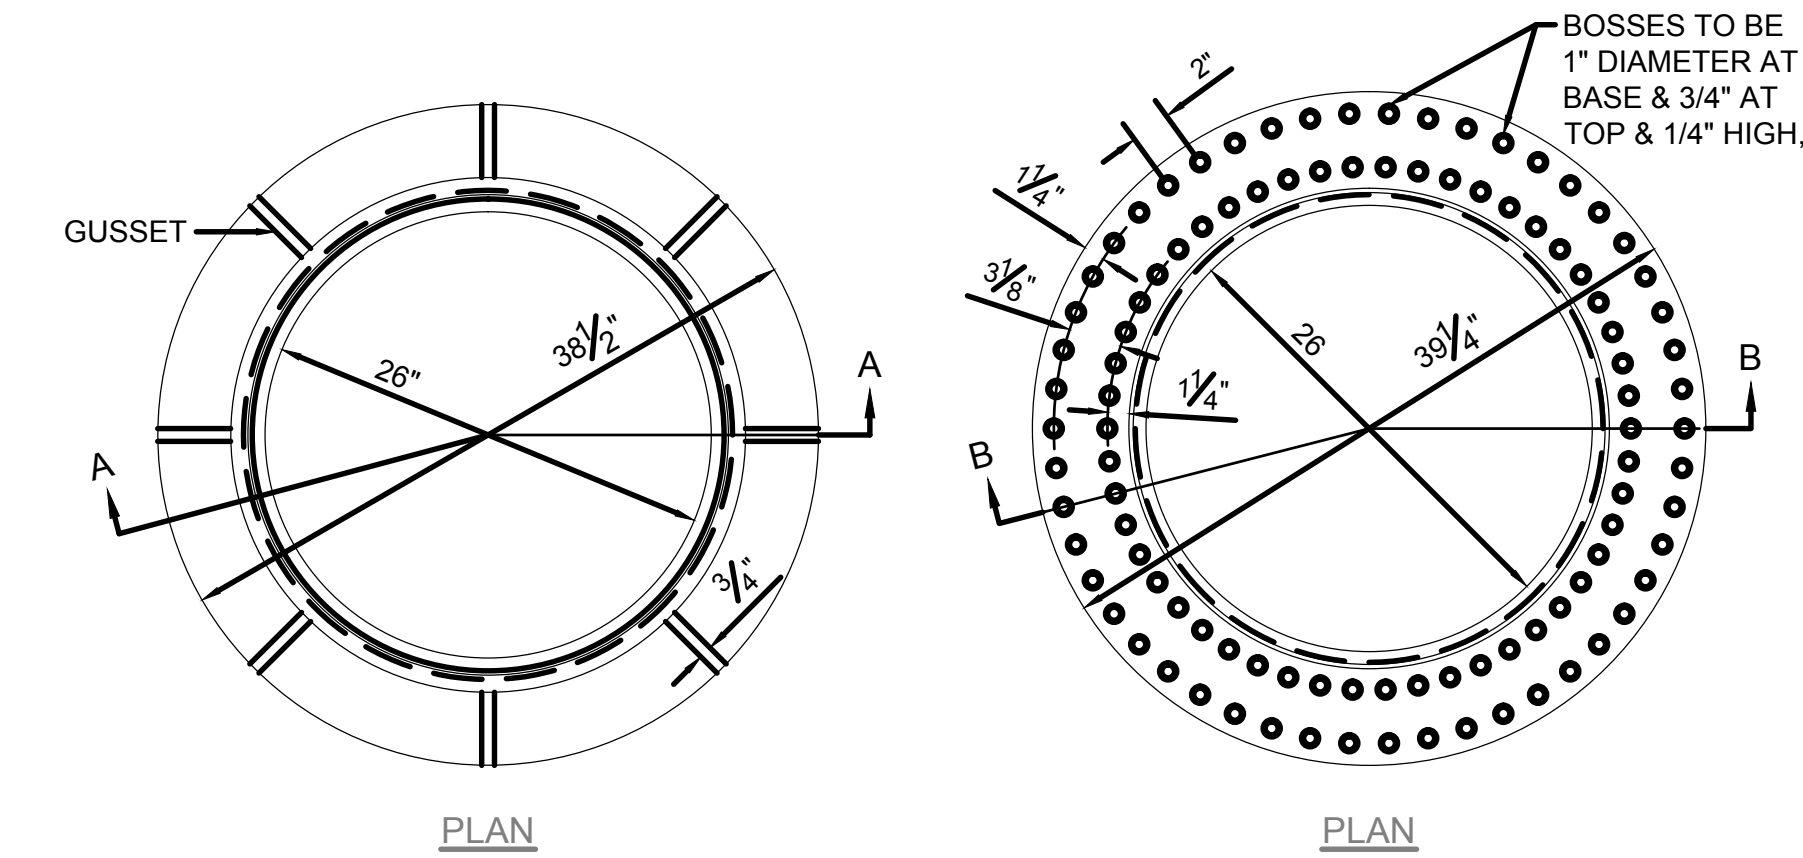


GENERAL NOTES:


- CASTINGS TO CONFORM TO THE A.S.T.M. SPECIFICATIONS FOR GRAY IRON CASTINGS, SERIAL DESIGNATION A 48-28.
- WHEN EACH COVER IS PLACED IN ANY POSITION IN ITS ASSOCIATED FRAME, THE SIDE PLAY IN ANY DIRECTION SHALL NOT EXCEED 1/8".
- TYPE A FRAMES SHALL BE USED ON PAVED STREETS AND ALLEYS.
- TYPE A FRAMES SHALL BE USED ON UNPAVED STREETS AND ALLEYS.
- NO WORDING OF MARKINGS OF ANY KIND OTHER THAN THOSE SHOWN ON THIS STANDARD WILL BE PERMITTED ON THESE CASTINGS.
- THE AVERAGE WEIGHT OF CASTINGS WILL NOT BE LESS THAN 98% OF WEIGHTS SHOWN.
- REVERSIBLE FRAME AND COVER D-204, MAY BE USED IN LIEU OF FRAME AND COVER SHOWN ON D-201.

CASTING WEIGHTS


"A" RING ONLY	347 LBS.
"B" RING ONLY	392 LBS.
COVER ONLY	251 LBS.
TOTAL TYPE "A"	598 LBS.
TOTAL TYPE "B"	643 LBS.

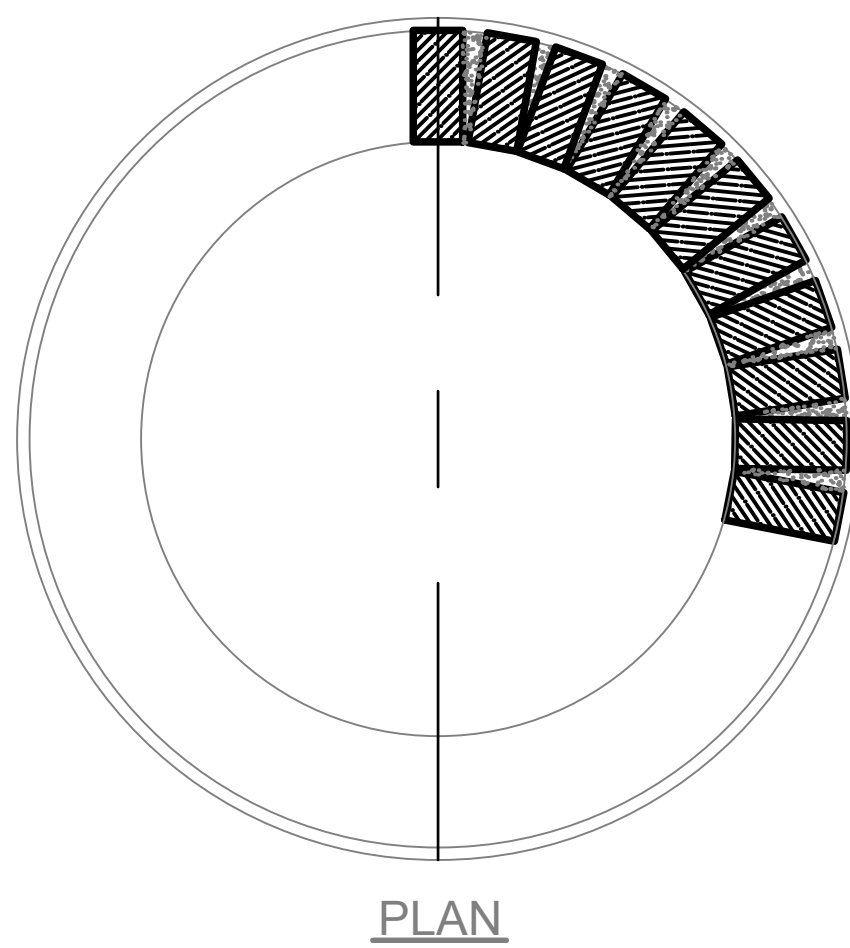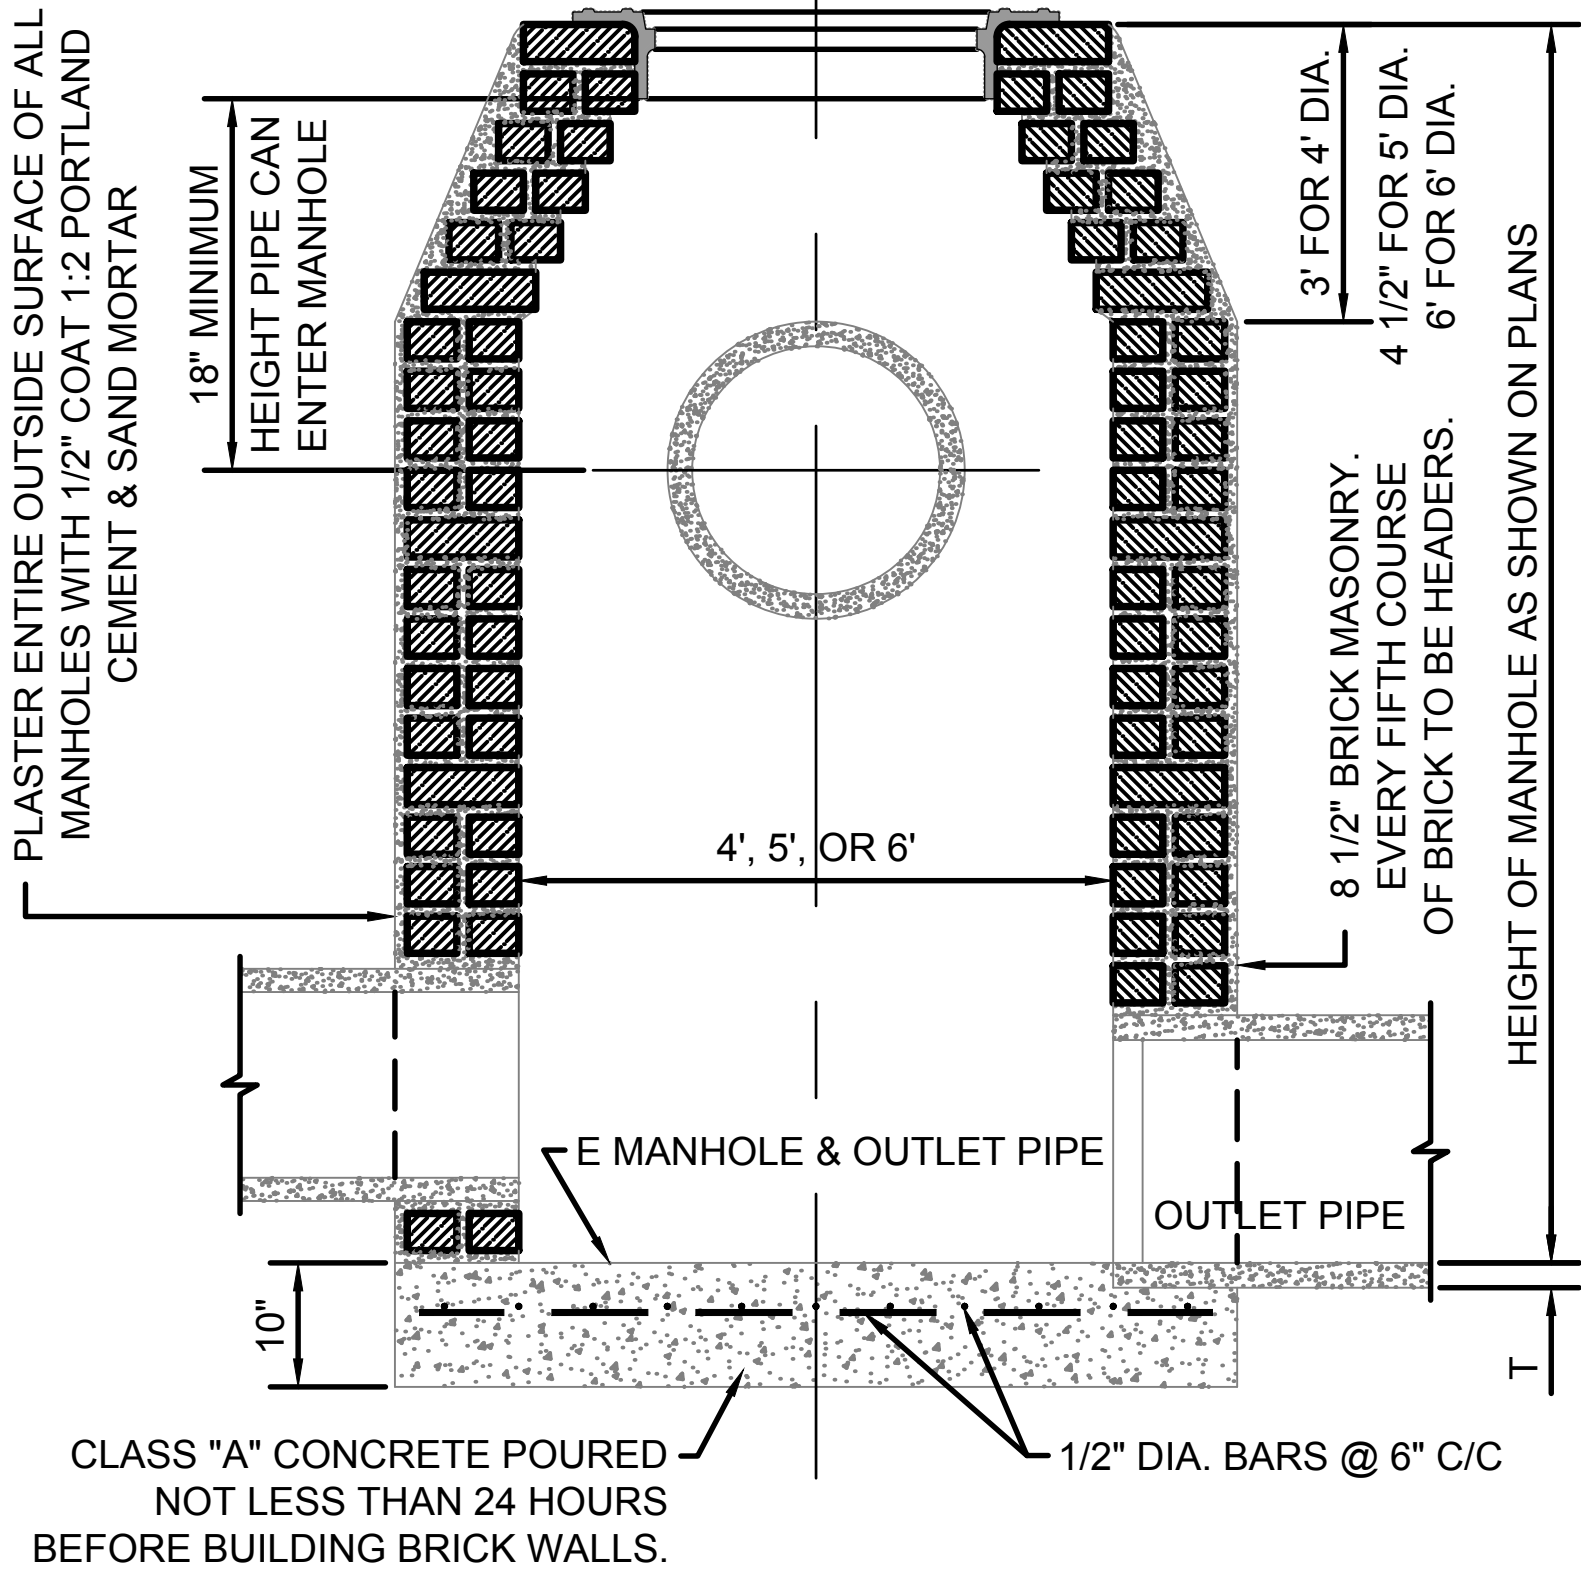

DETAIL OF STANDARD MASONRY MANHOLE

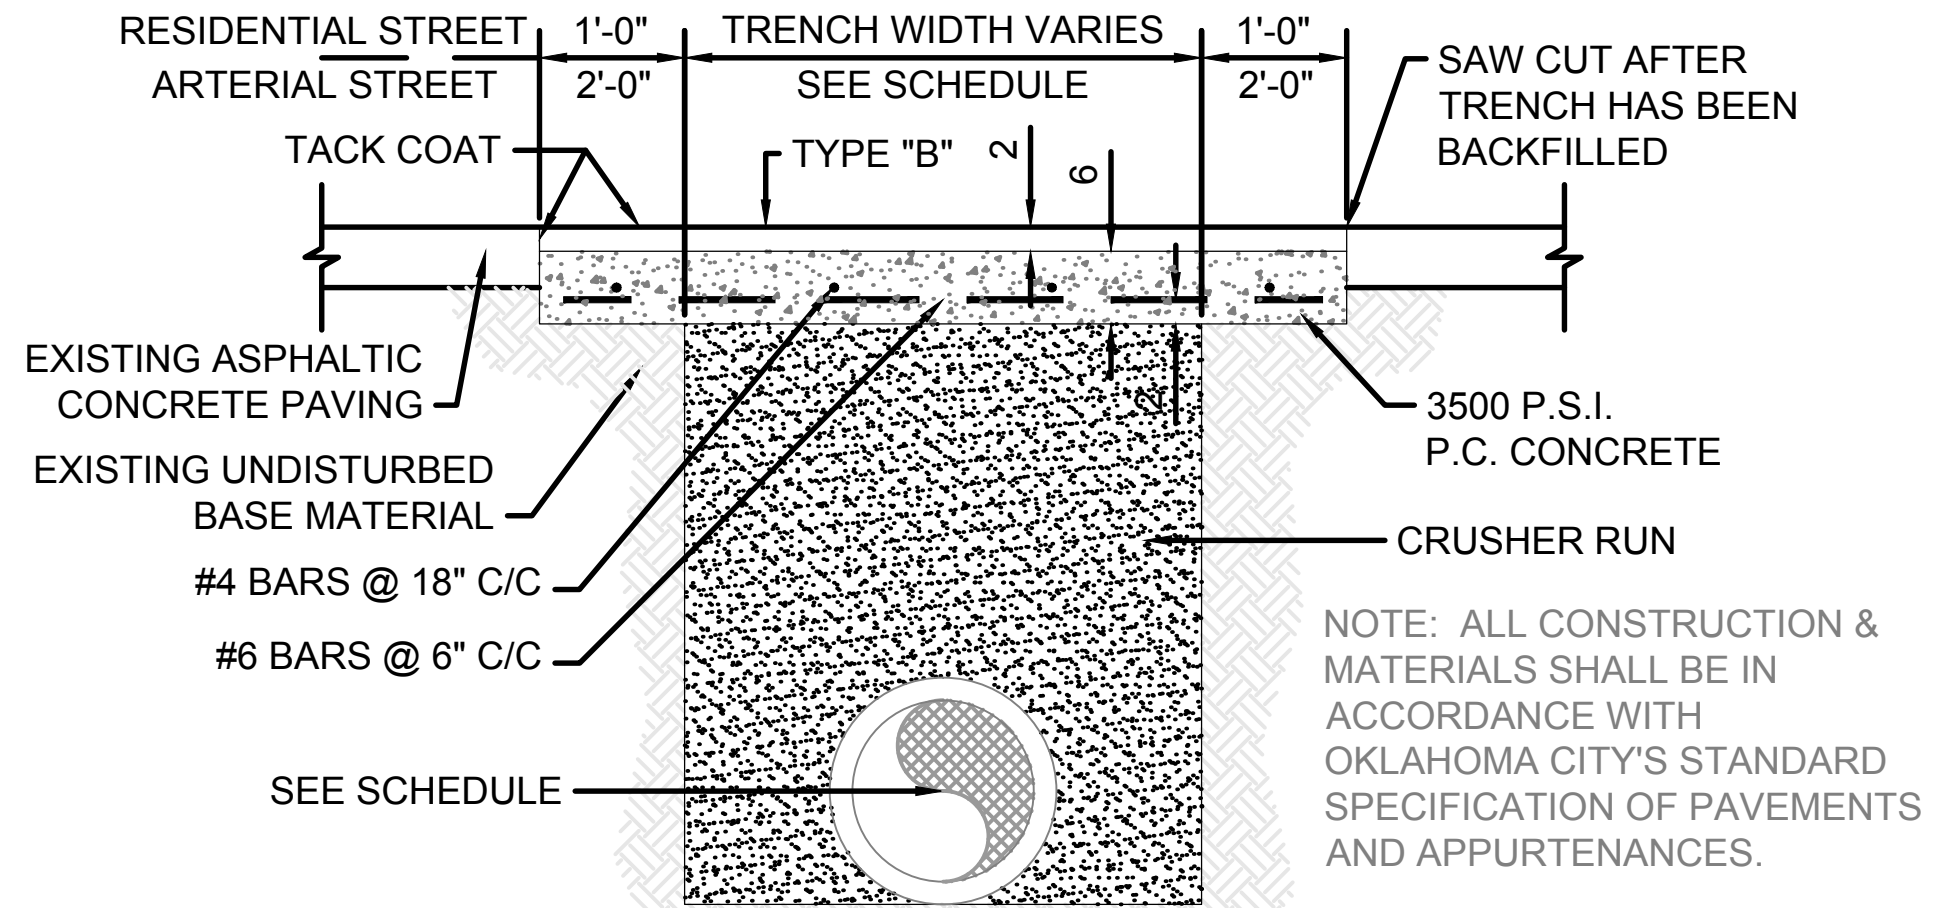

TYPICAL PERMANENT REPAIR SECTION FOR ASPHALT CONCRETE PAVING

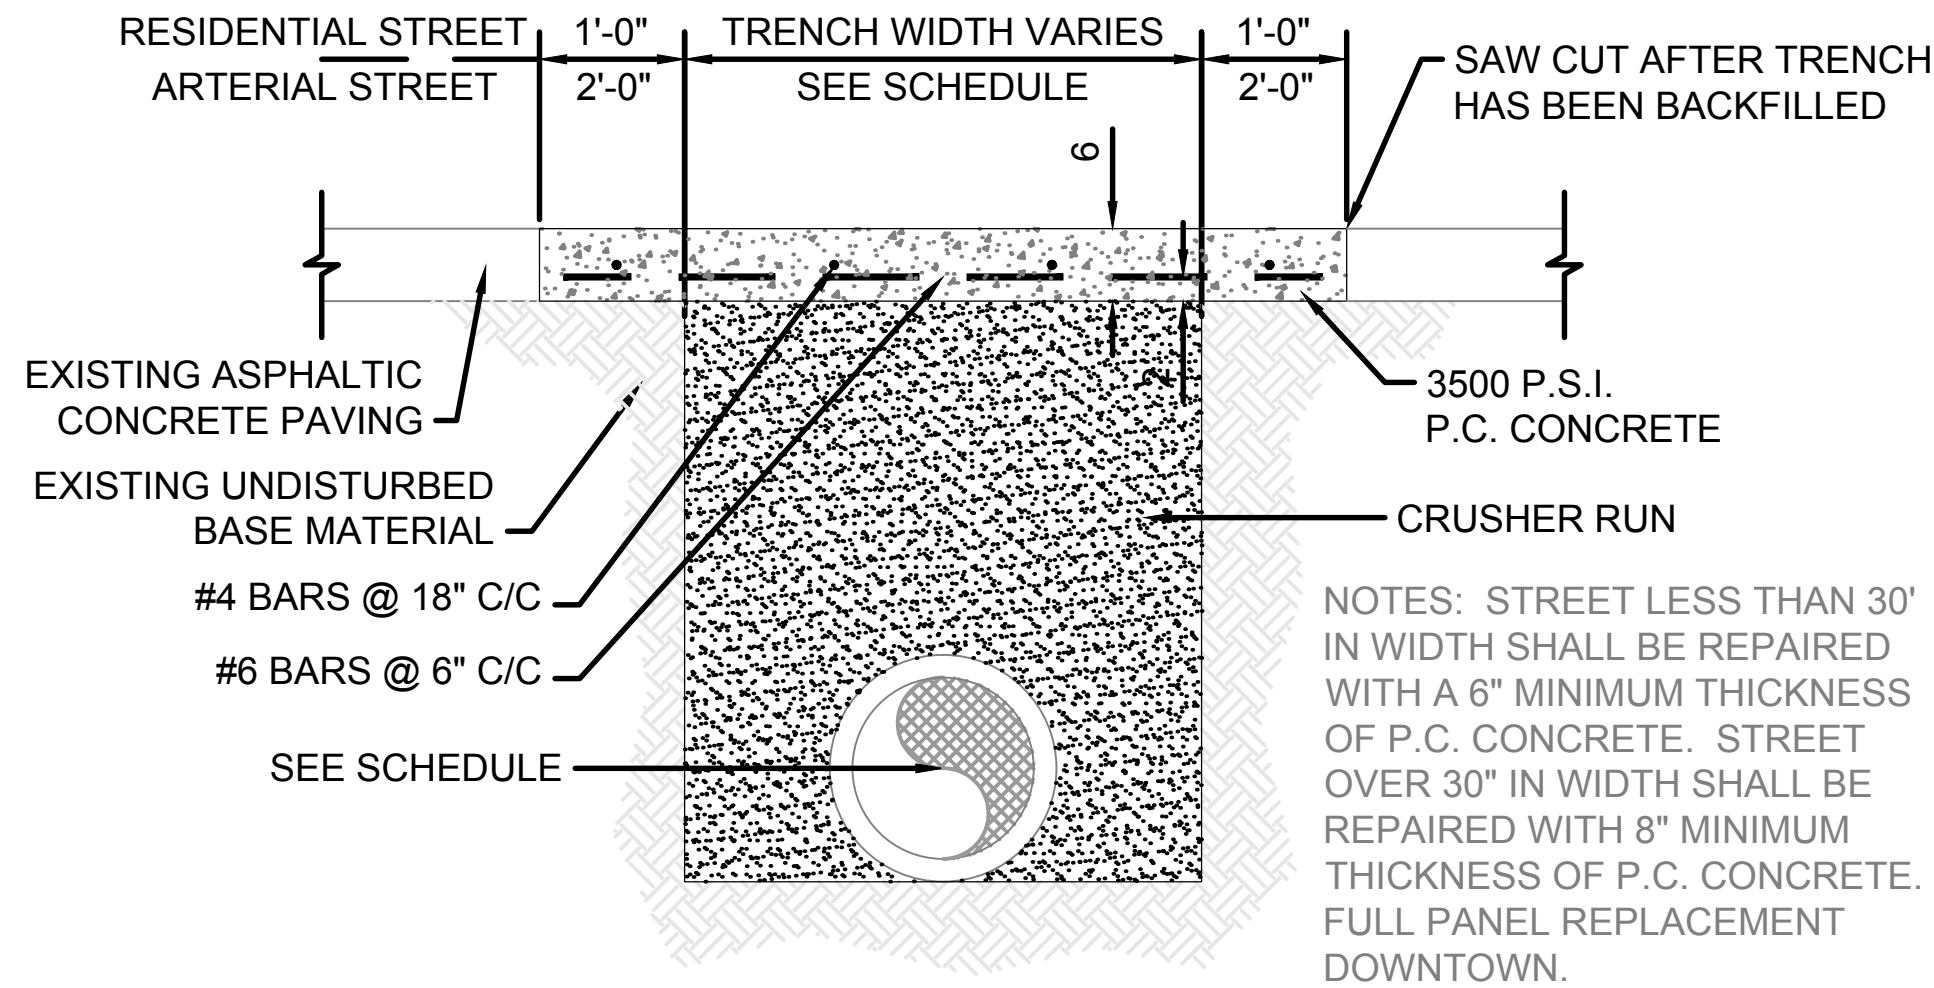


TYPICAL PERMANENT REPAIR SECTION FOR P.C. CONCRETE PAVING




TRENCH WIDTH SCHEDULE					
PIPE SIZE I.D.	12" OR LESS	15" TO 21"	24" TO 30"	33" TO 54"	60" & OVER
TRENCH WIDTH (W/O SHORING)	24"	O.D. + 12"	O.D. + 18"	O.D. + 15"	O.D. + 15"
TRENCH WIDTH (W/ SHORING)	36"	O.D. + 24"	O.D. + 30"	O.D. + 30"	O.D. + 36"

OKLAHOMA CITY
PUBLIC WORKS DEPARTMENT
ENGINEERING DIVISION

STANDARD MASONRY MANHOLE


APPROVED:  DATE: 11/7/06
DENNIS G. LOWERS, P.E.
CITY ENGINEER

DRAWN: V.S.C. DATE: 11/07/06 DWG. NO. D-201

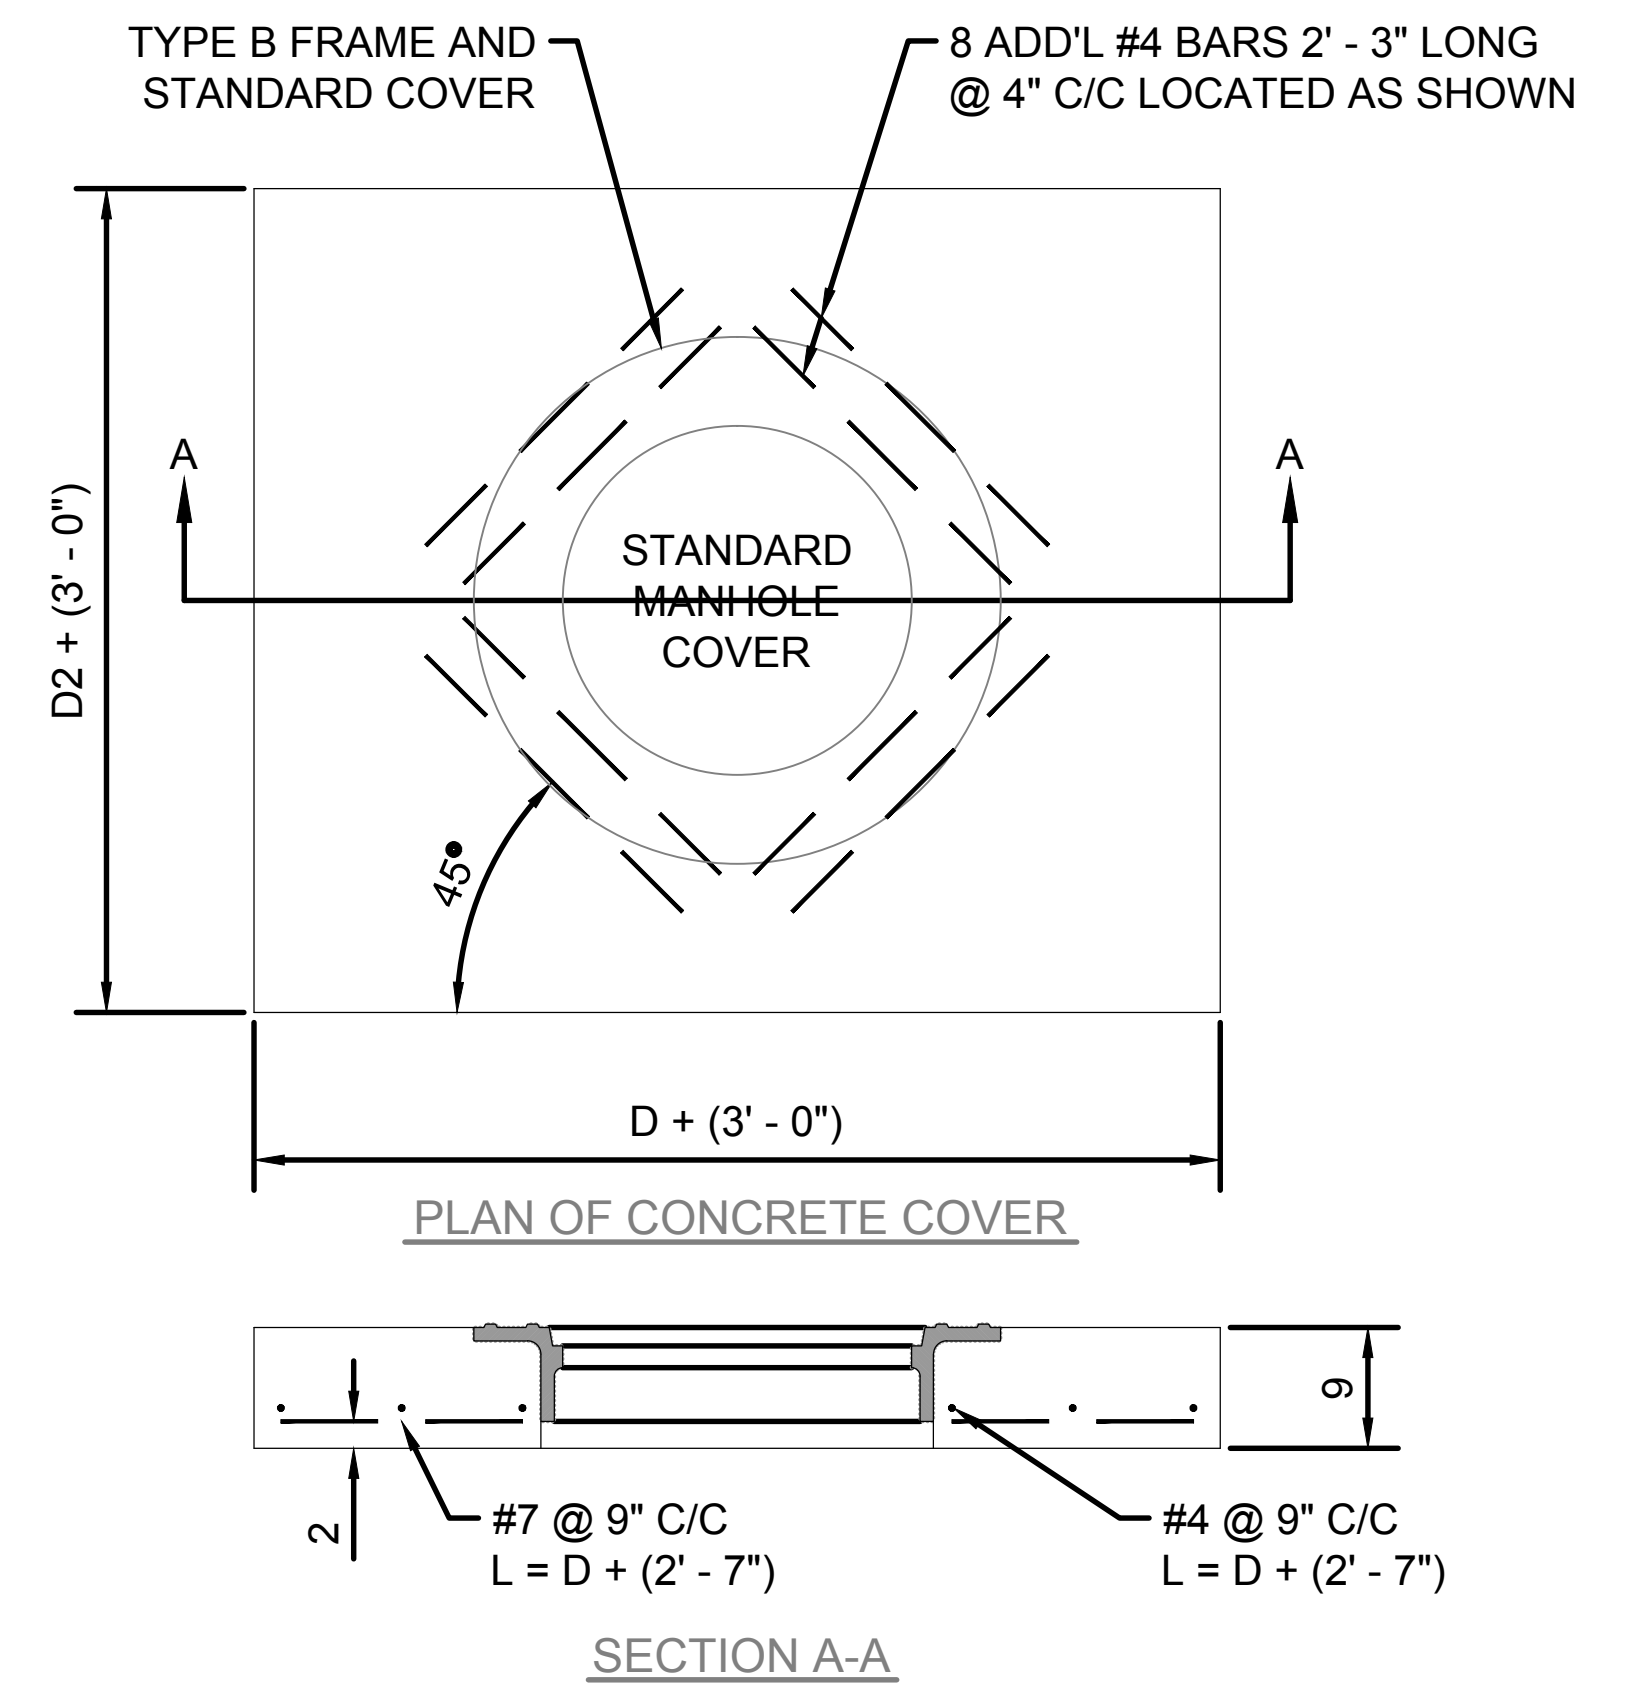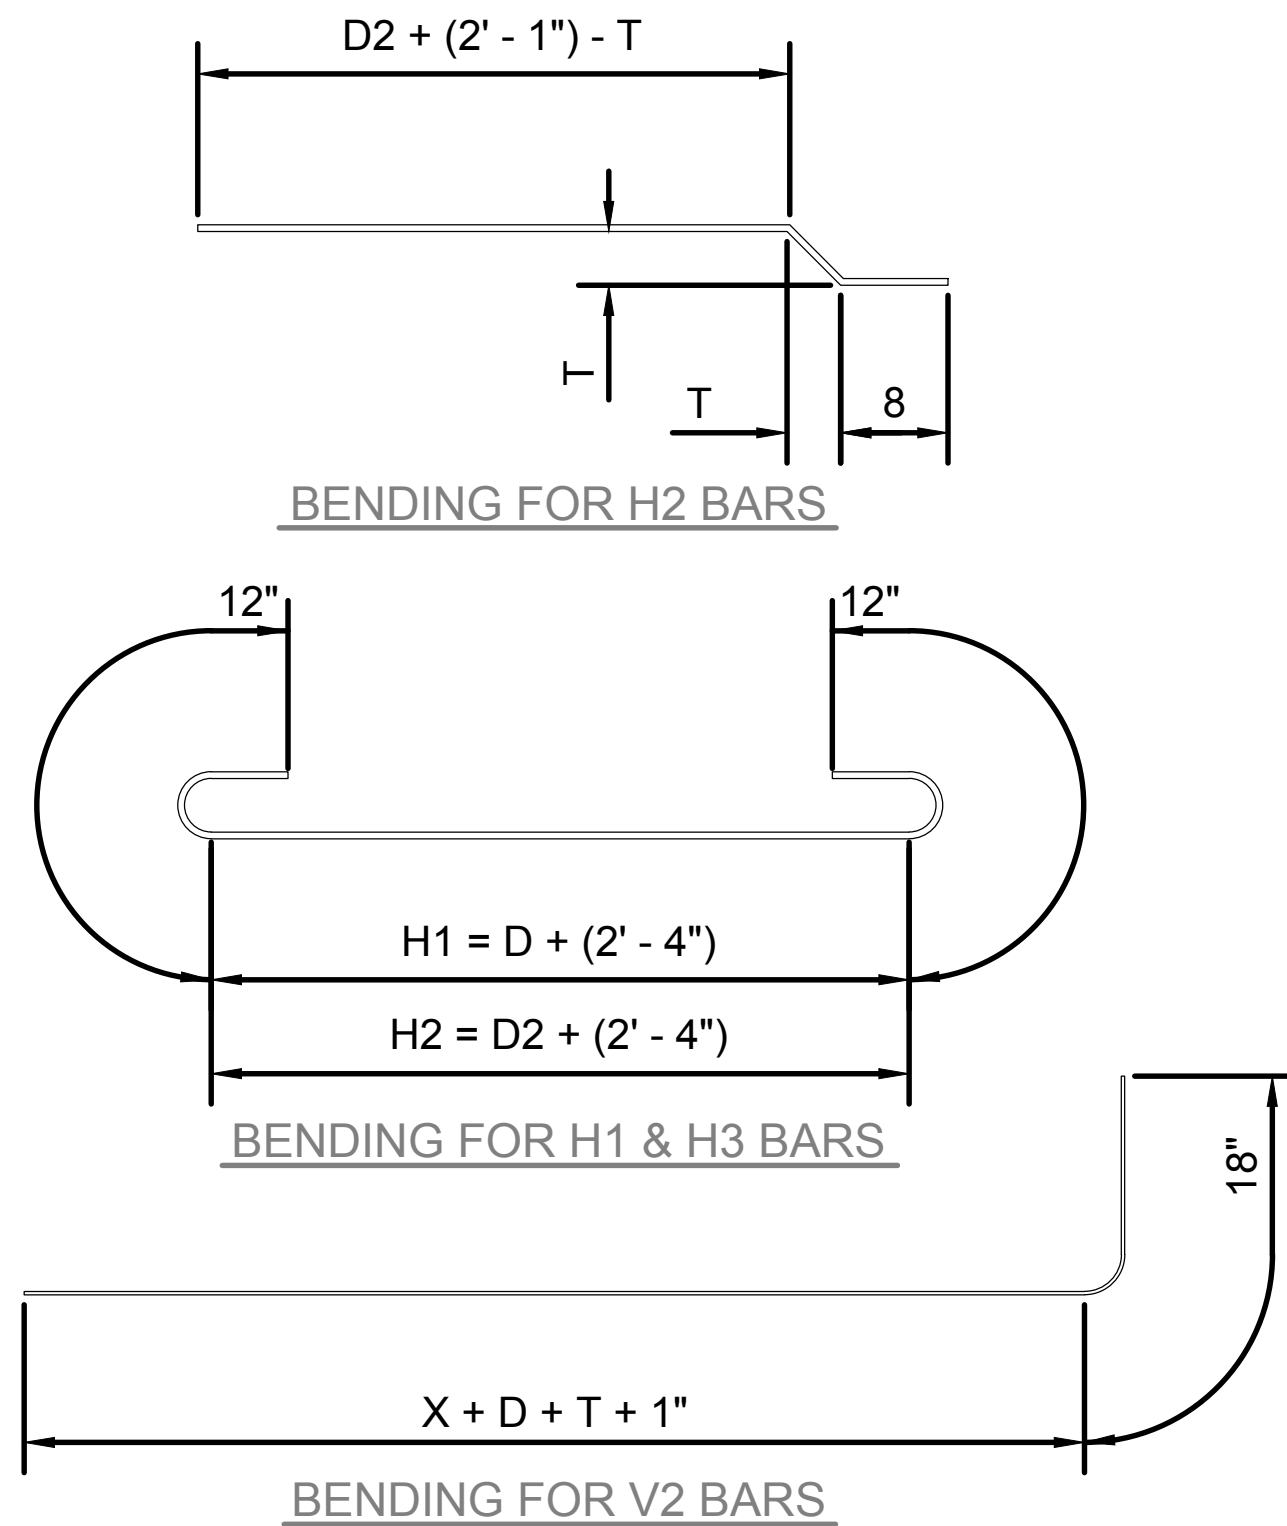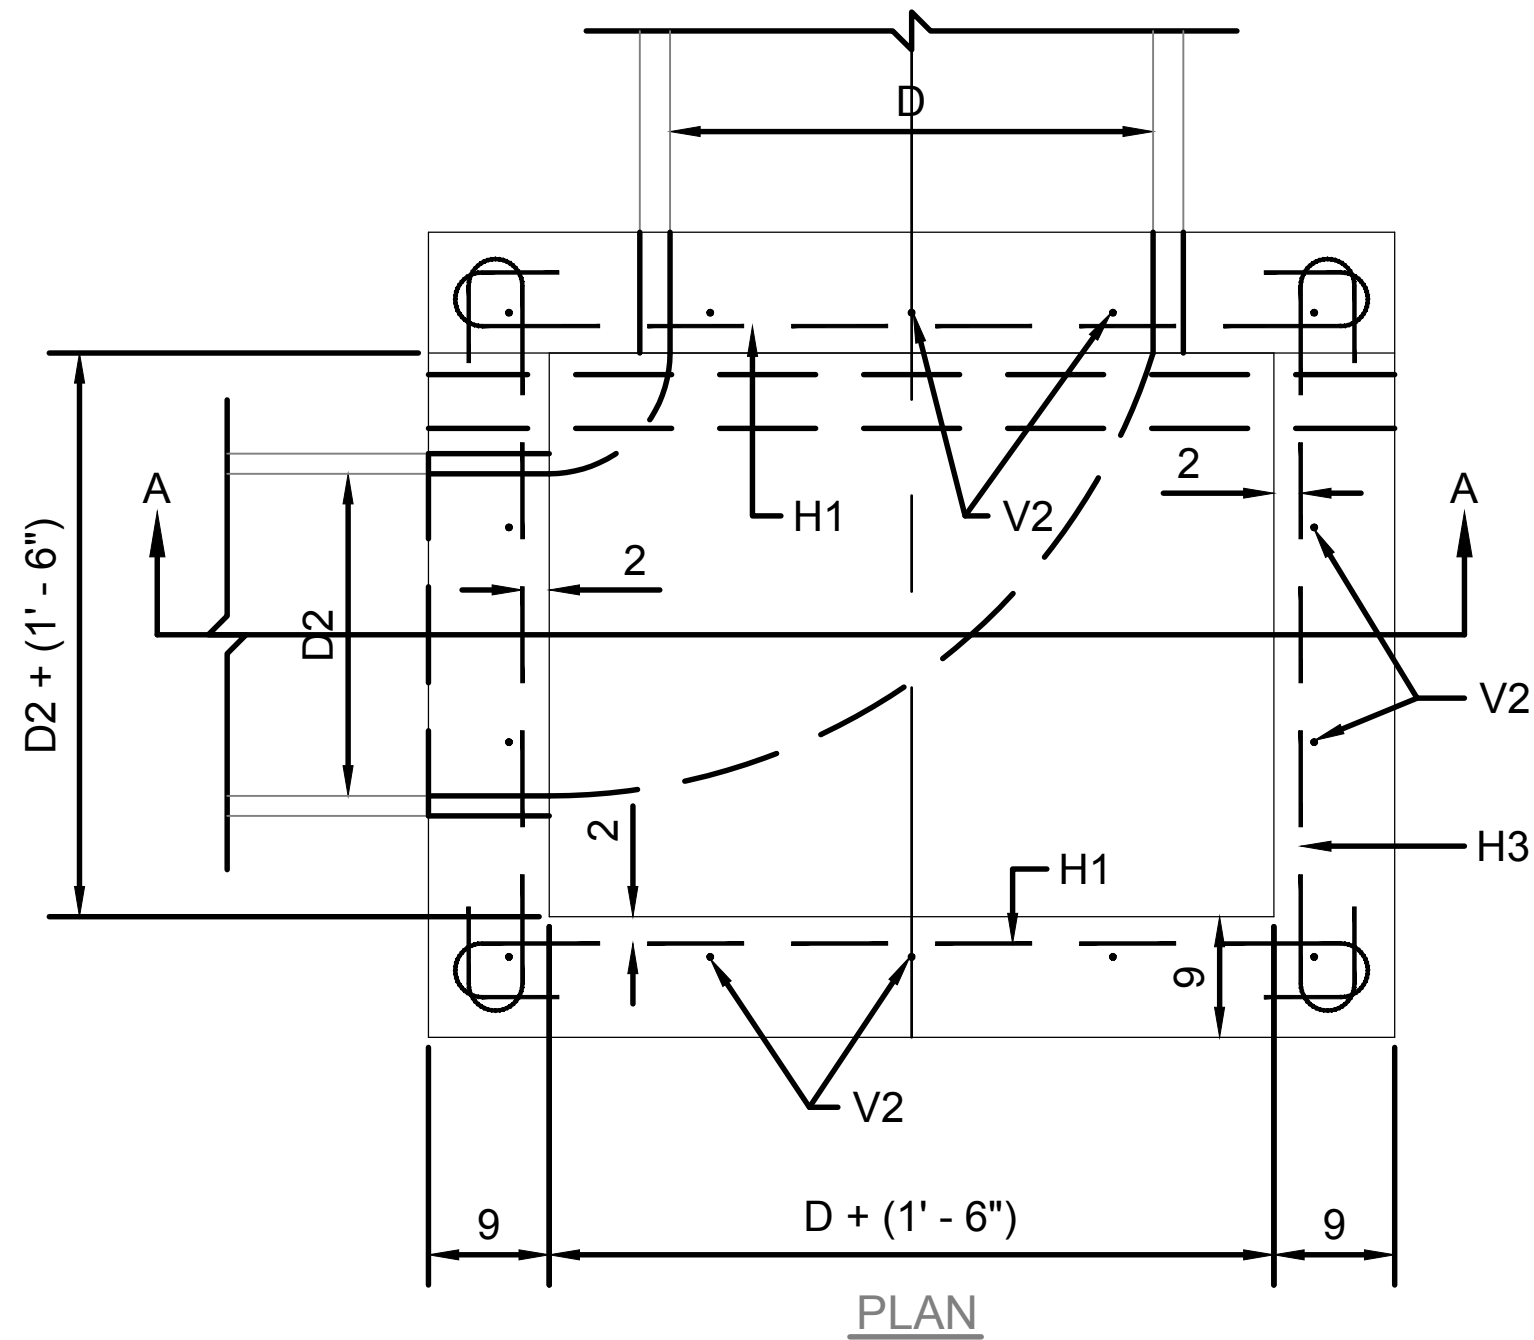


GENERAL NOTES:


- ALL CONSTRUCTION SHALL BE IN ACCORDANCE WITH OKLAHOMA CITY STANDARD SPECIFICATIONS.
 - ALL EXPOSED CONCRETE SURFACES SHALL HAVE A CARBORUNDUM FINISH.
 - ALL EXPOSED CONCRETE SURFACES SHALL HAVE A 3/4" CHAMFER
 - ALL REINFORCED STEEL SHALL BE 1/2" DIAMETER, EXCEPT AS NOTED. ALL HORIZONTAL BARS SHALL BE SPACED AS SHOWN. (18" MAXIMUM)
 - MAXIMUM DEPTHS OF BOXES FOR 48" TO 72" R.C.P. SHALL BE AS FOLLOWS:
48" - 18'; 54" - 16'; 60" - 12'; 72" - 10'.
 - REINFORCED CONCRETE PIPE SHALL CONFORM TO THE REQUIREMENTS OF A.A.S.H.T.O. M-170 (ASTM C-78) CLASS III UNLESS OTHERWISE DESIGNATED.
 - WALL THICKNESS (DIMENSION "T") OF PIPES SHOWN, ARE FROM "WALL B" COLUMN OF A.A.S.H.T.O. TABLES.
- | D | 36" | 42" | 48" | 54" | 60" | 66" | 72" |
|---|-----|--------|-----|--------|-----|--------|-----|
| T | 4" | 4 1/2" | 5" | 5 1/2" | 6" | 6 1/2" | 7" |
- DIMENTION D2 IS THE DIAMETER OF THE LARGEST PIPE ENTERING THE JUNCTION BOX THROUGH THE SIDE.
 - DIMENTION "X" DEPENDS ON THE DEPTHS AS CALLED FOR IN THE PLANS.

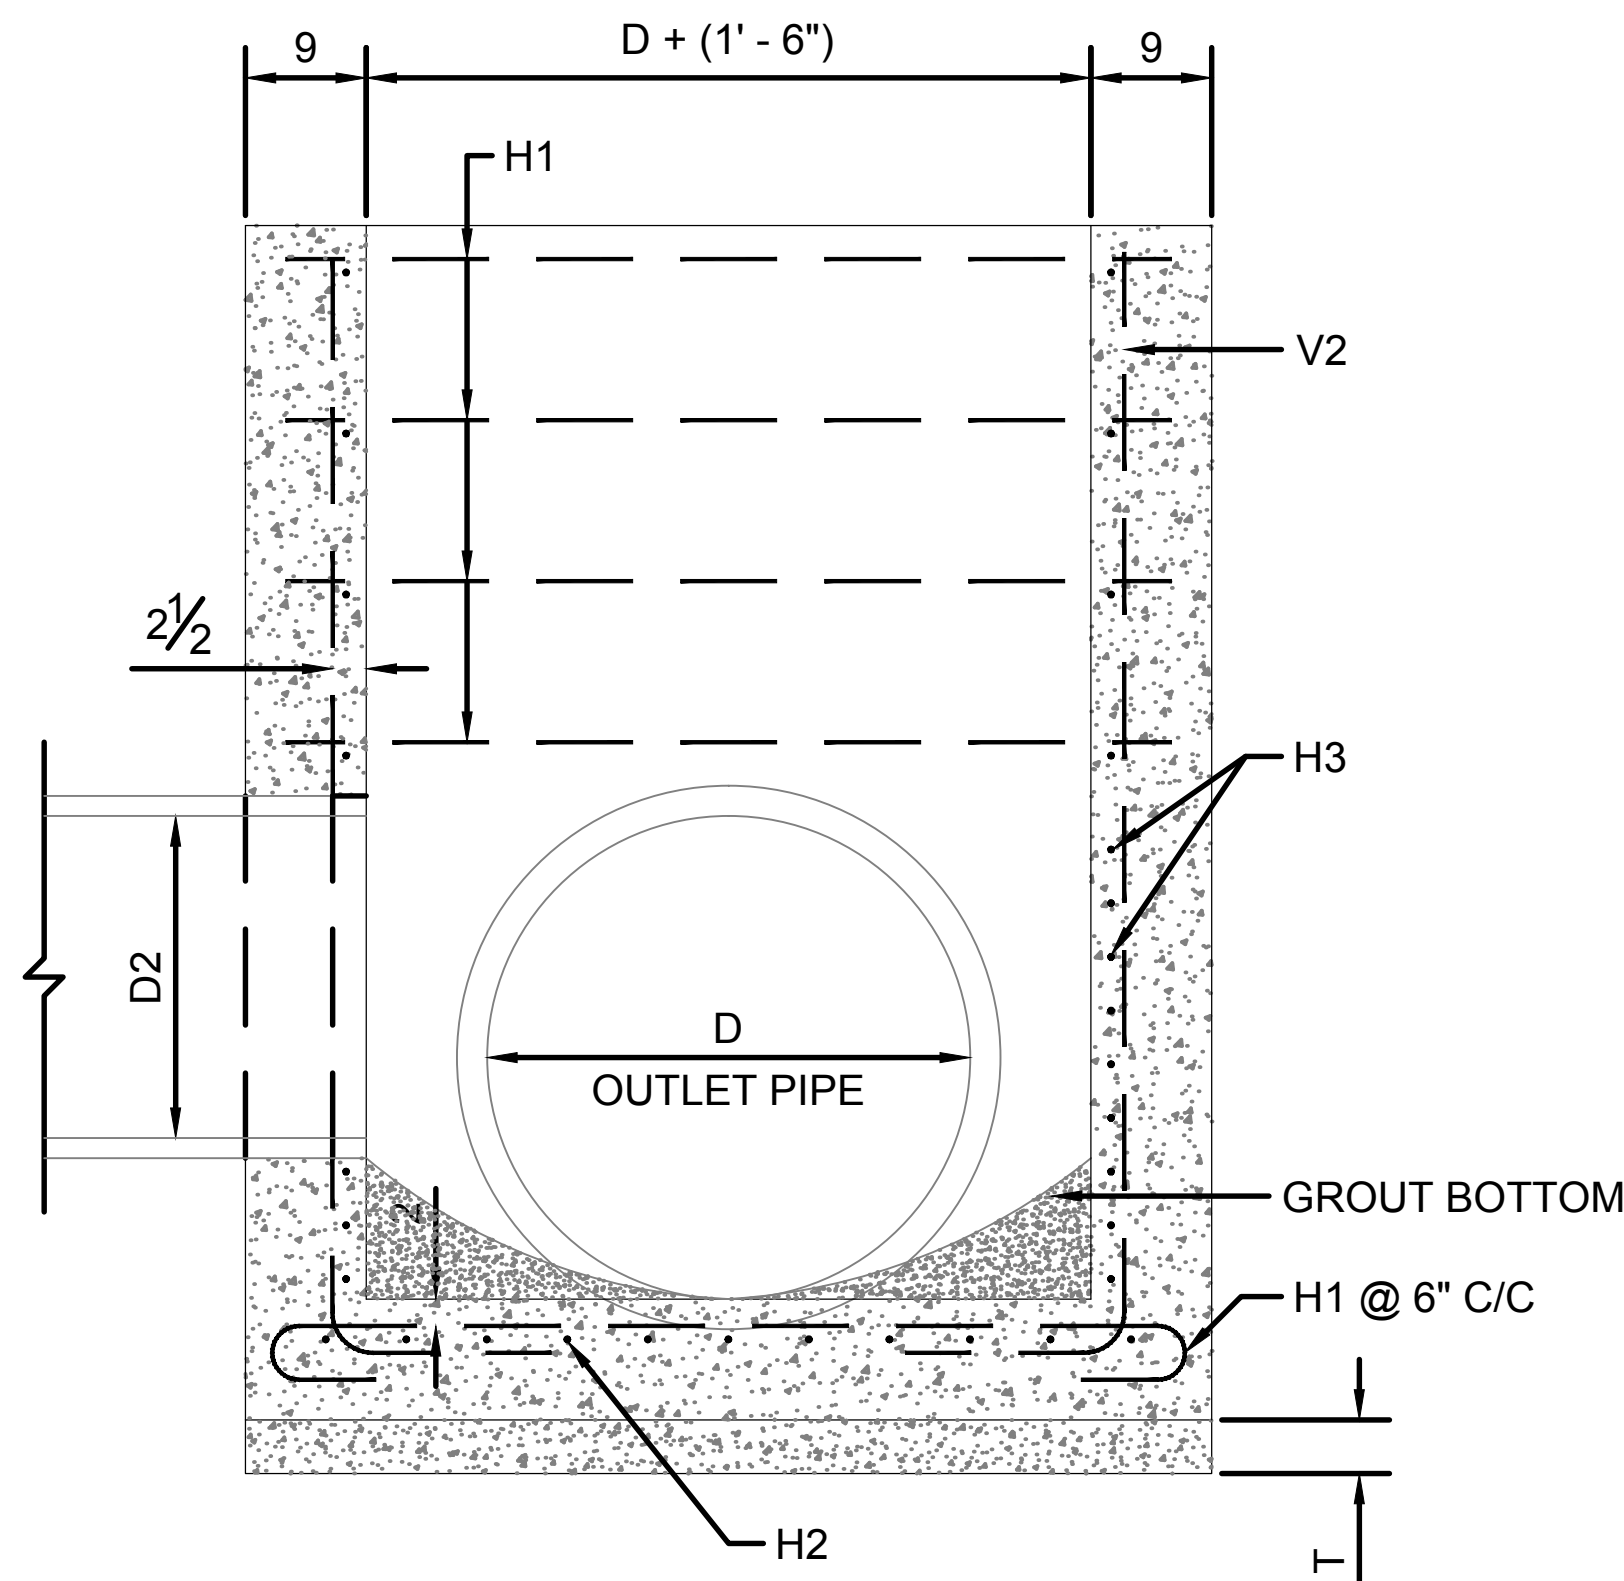


JUNCTION BOX 36" TO 72"
REINFORCED CONCRETE PIPE

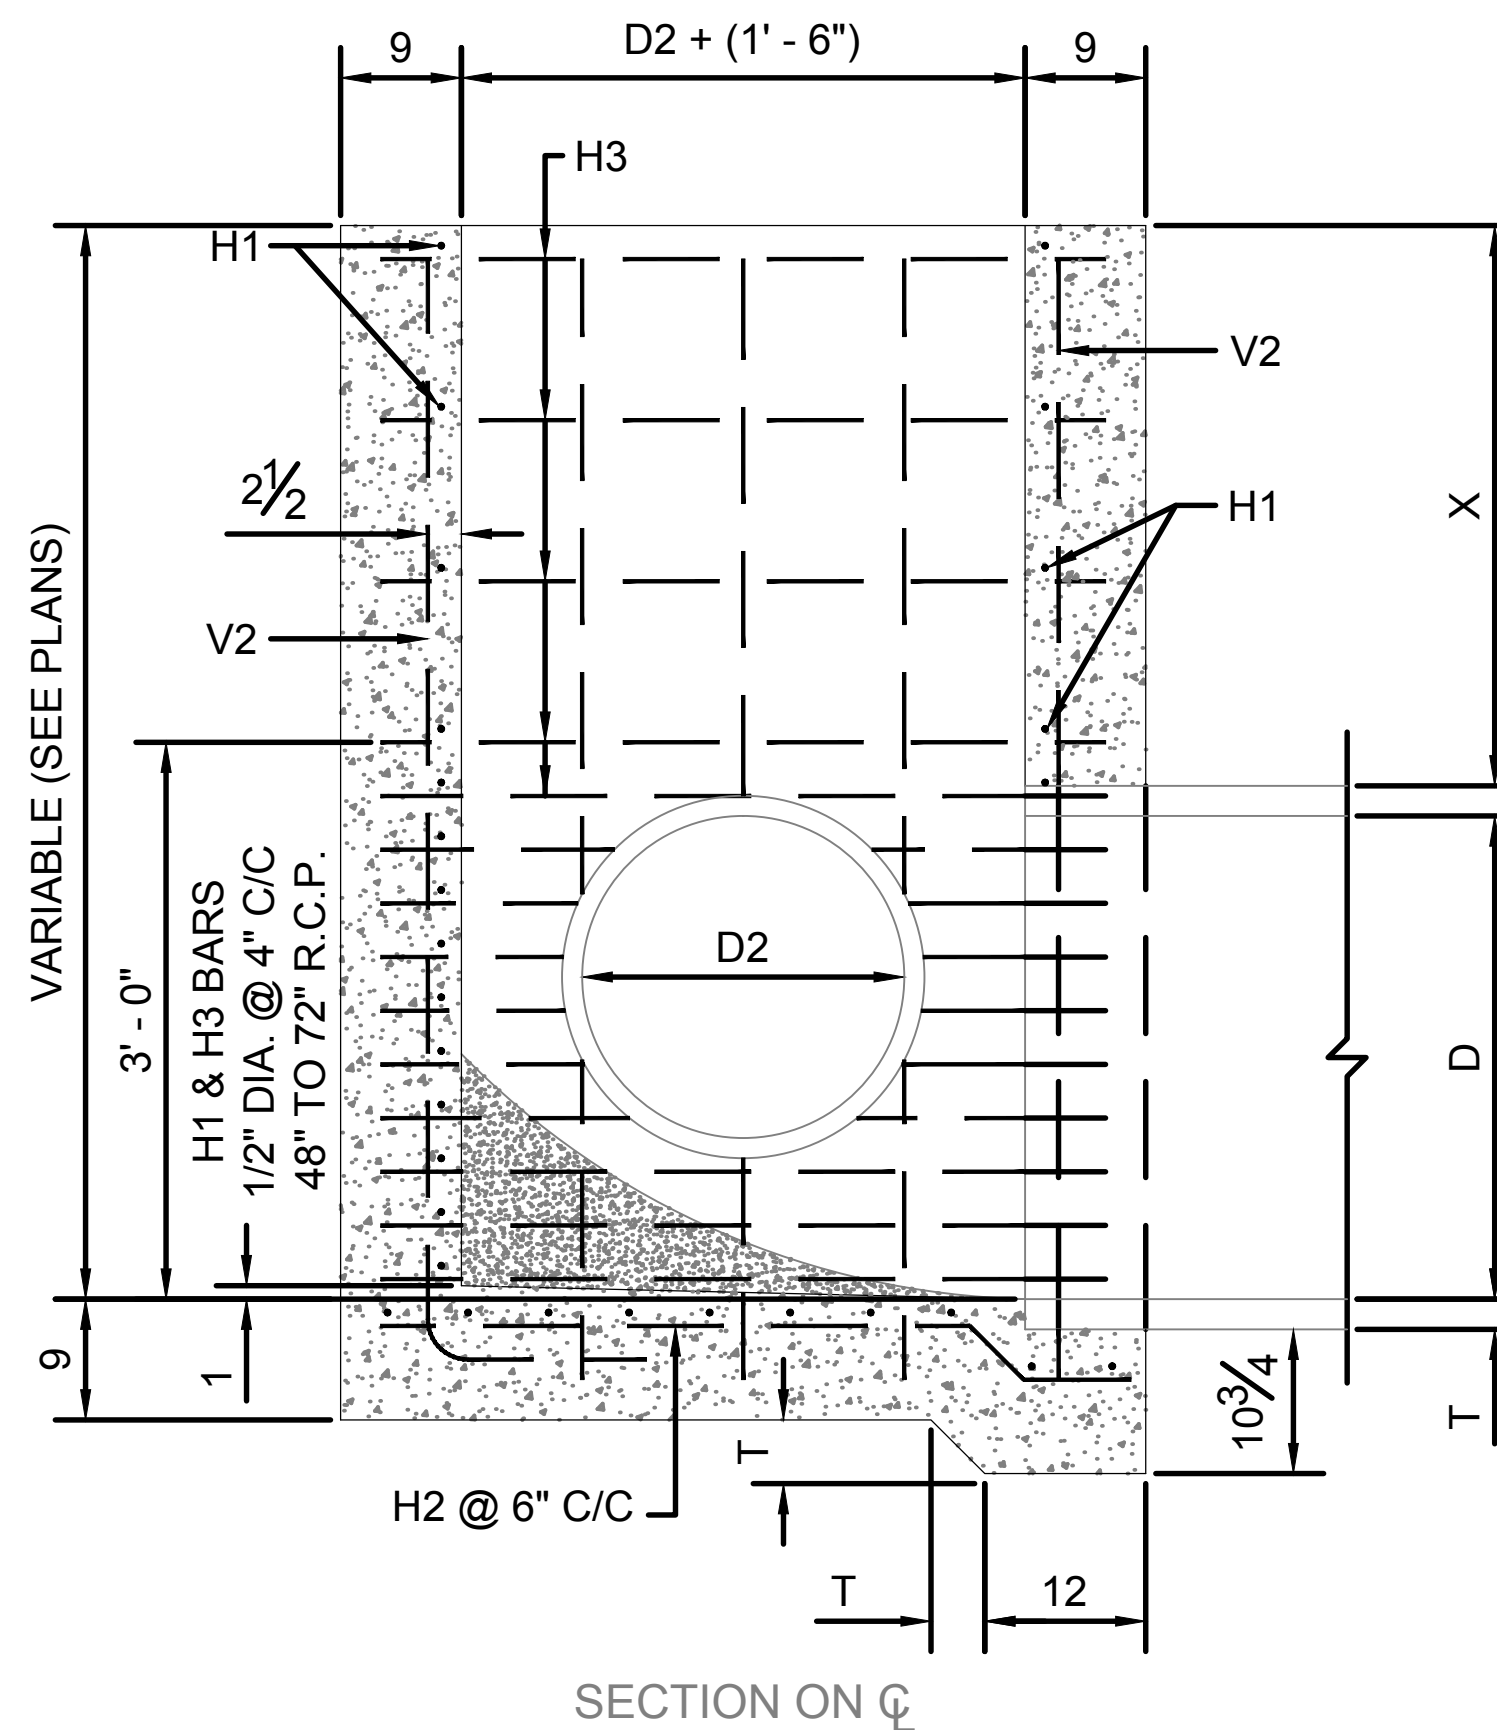


OKLAHOMA CITY PUBLIC WORKS DEPARTMENT ENGINEERING DIVISION			
STANDARD REINFORCED CONCRETE JUNCTION BOX FOR 36" TO 72" REINFORCED CONCRETE PIPE			
APPROVED BY: <i>Paul Harum</i> PAUL HARUM, P.E. CITY ENGINEER	DATE: 7-11-21	DRAWN: V.S.C.	DATE: 04/16/01
DWG. NO. D-203			

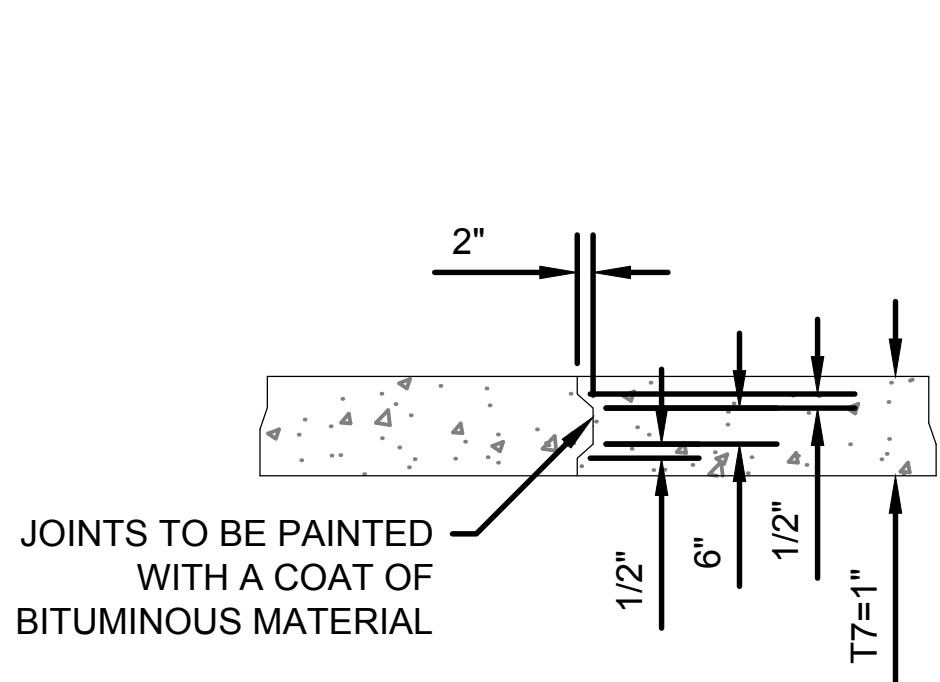

DETAIL OF CONSTRUCTION JOINT

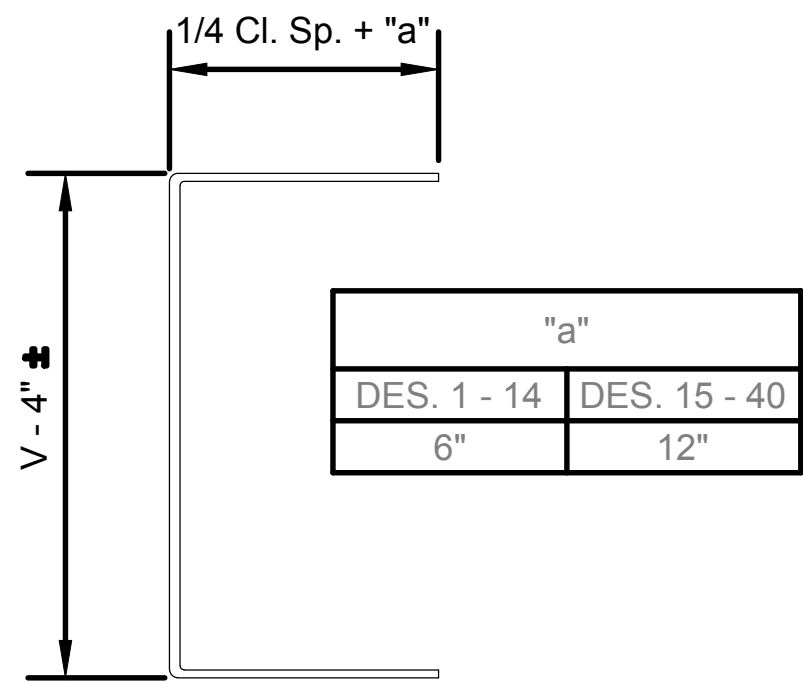


B - BAR
(SEE TABLE FOR TOTAL LENGTH)

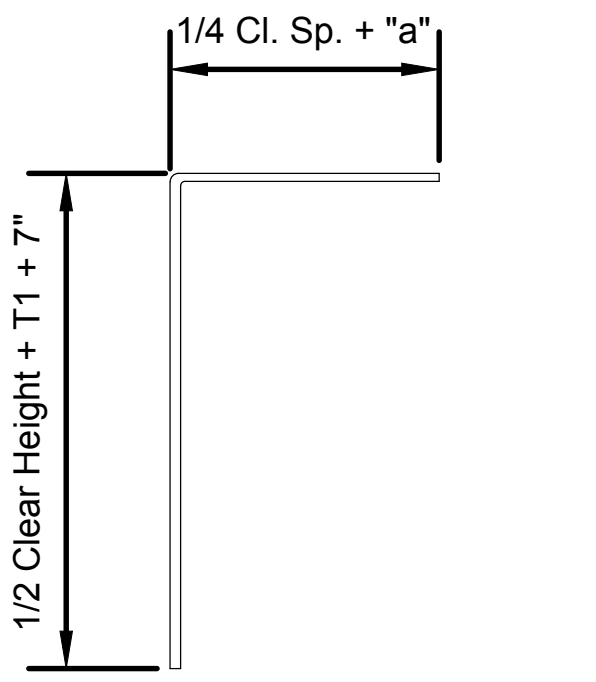

B1 - BAR
(SEE TABLE FOR TOTAL LENGTH)

LIVE LOAD HS 20

Note:
R.C.B. DESIGN FOR
FILL FROM 0' TO 8'.

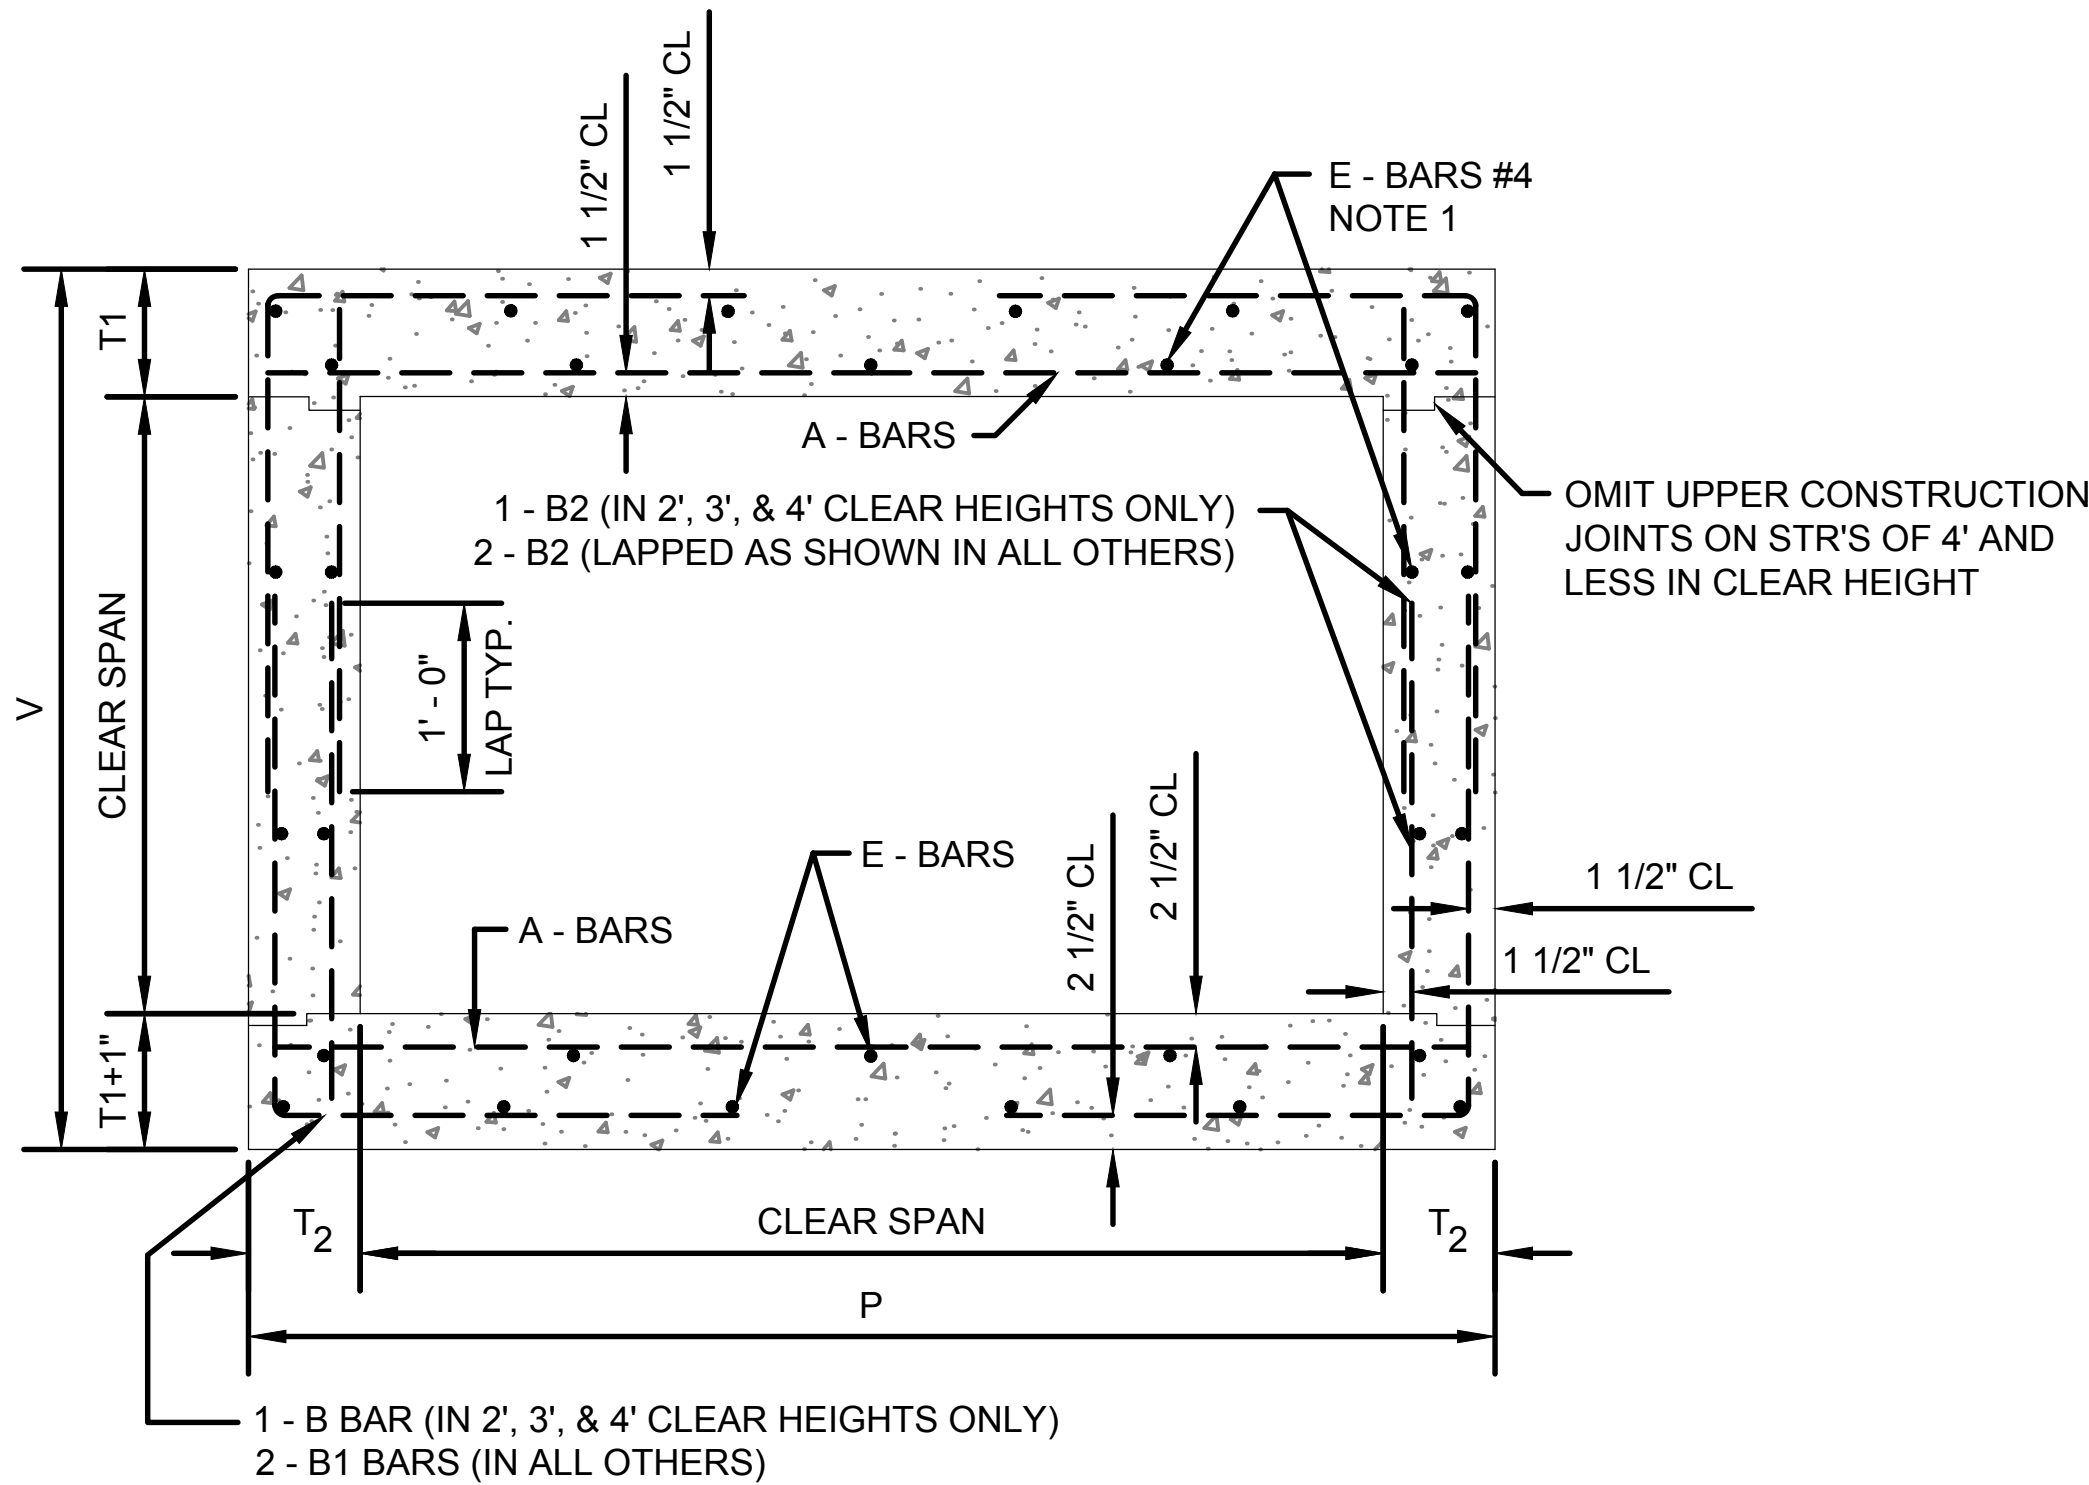

TYPICAL BARREL SECTION

* 0' - 9" $\frac{1}{4}$ " ADDED TO EACH BAR FOR LAP.
1 SPACING FOR BOTTOM OF TOP SLAB. ALL OTHERS @ 18" MAXIMUM

R.C.B. DESIGN FOR
FILL FROM 0' TO 8'.

CLEAR SPAN	CLEAR HEIGHT	AREA SQ. FT.	DES NO.	DIMENSIONS				REINFORCING											QUANTITIES FOR ONE PEDESTAL		QUANTITIES PER LINEAR FT. OF BARREL				
								A - BARS			B - BARS			B1 - BARS		B2 - BARS		E - BARS #4							
				T1	T2	V	P	SIZE	SPC.	LNG.	SIZE	SPC.	LNG.	SIZE	SPC.	LNG.	SIZE	SPC.	LENGTH	NO	#	STEEL - LB.	CONC. C.Y.	STEEL - LB.	CONC. C.Y.
2'	2	4	1	6"	6"	3' - 1"	3' - 0"	#5	9"	2' - 8"	#4	15"	4' - 9"				#4	18"	2 @ 2' - 9"	19	9 1/4"	30	.21	27.64	.194
3'	2	6	2	6 1/4"	6"	3' - 1 1/2"	4' - 0"	#6	10 1/2"	3' - 8"	#4	11 1/2"	5' - 4"				#4	18"	2 @ 2' - 10"	21	8"	30	.28	36.85	.241
	2.5	7.5	3	6 1/4"	6"	3' - 7 1/2"	4' - 0"	#6	10"	3' - 8"	#4	11 1/2"	5' - 10"				#4	18"	2 @ 3' - 4"	21	8"	30	.28	38.35	.259
	3	9	4	6 1/4"	6"	4' - 1 1/2"	4' - 0"	#6	10"	3' - 8"	#4	11 1/2"	6' - 4"				#4	18"	2 @ 3' - 10"	21	8"	30	.28	39.49	.278
4'	2	8	5	7"	6"	3' - 3"	5' - 0"	#6	9"	4' - 8"	#4	10 1/2"	5' - 11"				#4	18"	2 @ 2' - 11"	23	8 3/4"	40	.35	45.68	.305
	2.5	10	6	7"	6"	3' - 9"	5' - 0"	#6	9"	4' - 8"	#4	10 1/2"	6' - 5"				#4	18"	2 @ 3' - 5"	23	8 3/4"	40	.35	46.88	.324
	3	12	7	7"	6"	4' - 3"	5' - 0"	#6	9"	4' - 8"	#4	9 1/2"	6' - 11"				#4	18"	2 @ 3' - 11"	27	8 3/4"	40	.35	50.77	.342
	4	16	8	7"	6"	5' - 3"	5' - 0"	#6	8 1/2"	4' - 8"	#4	12"	7' - 11"				#4	18"	2 @ 4' - 11"	27	8 3/4"	40	.35	52.80	.379
5'	2	10	9	7 1/2"	6"	3' - 4"	6' - 0"	#6	8"	5' - 8"	#4	10 1/2"	6' - 6"				#4	18"	2 @ 3' - 0"	26	8"	50	.42	56.54	.370
	3	15	10	7 1/2"	6"	4' - 4"	6' - 0"	#6	8"	5' - 8"	#4	11"	7' - 6"				#4	18"	2 @ 4' - 0"	30	8"	50	.42	60.07	.407
	4	20	11	7 1/2"	6"	5' - 4"	6' - 0"	#6	7 1/2"	5' - 8"	#4	12"	8' - 6"				#4	18"	2 @ 5' - 0"	30	8"	50	.42	63.08	.444
	5	25	12	7 1/2"	6"	6' - 4"	6' - 0"	#6	7"	5' - 8"				#4	12"	5' - 6"	#4	18"	4 @ 3' - 9" *	34	8"	50	.42	73.26	.481
6'	3	18	13	8"	6"	4' - 5"	7' - 0"	#6	7"	6' - 8"	#4	11"	8' - 1"				#4	18"	2 @ 4' - 1"	31	8 1/2"	60	.49	70.45	.478
	4	24	14	8"	7"	5' - 5"	7' - 2"	#6	7"	6' - 10"	#4	10 1/2"	9' - 1"				#4	18"	2 @ 5' - 1"	31	8 1/2"	60	.50	74.27	.548
	5	30	15	8"	8"	6' - 5"	7' - 4"	#6	7 1/2"	7' - 0"				#5	10 1/2"	6' - 3"	#4	18"	4 @ 3' - 10" *	39	8 1/2"	60	.51	83.94	.631
	6	36	16	8"	8"	7' - 5"	7' - 4"	#6	7 1/2"	7' - 0"				#5	10 1/2"	6' - 9"	#4	18"	4 @ 4' - 4" *	39	8 1/2"	60	.51	86.22	.680
8'	3	24	17	9"	8"	4' - 7"	9' - 4"	#7	10"	9' - 0"	#5	9 1/2"	10' - 3"				#4	18"	2 @ 4' - 3"	37	9"	80	.65	99.66	.694
	4	32	18	9"	8"	5' - 7"	9' - 4"	#7	9 1/2"	9' - 0"	#5	11"	11' - 3"				#4	18"	2 @ 5' - 3"	37	9"	80	.65	101.48	.744
	5	40	19	9"	8"	6' - 7"	9' - 4"	#7	9"	9' - 0"				#5	11"	6' - 10"	#4	18"	4 @ 3' - 11" *	41	9"	80	.65	114.52	.793
	6	48	20	9"	9"	7' - 7"	9' - 6"	#7	9 1/2"	9' - 2"				#5	10"	7' - 4"	#4	18"	4 @ 4' - 5" *	41	9"	80	.66	119.32	.890
	7	56	21	9"	9"	8' - 7"	9' - 6"	#7	9 1/2"	9' - 2"				#5	10"	7' - 10"	#4	18"	4 @ 4' - 11" *	45	9"	80	.66	125.38	.945
	8	64	22	9"	9"	9' - 7"	9' - 6"	#7	9"	9' - 2"				#5	10"	8' - 4"	#4	18"	4 @ 5' - 4" *	49	9"	80	.66	133.91	1.001
10'	3	30	23	10"	8"	4' - 9"	11' - 4"	#7	9"	11' - 0"	#5	8 1/2"	11' - 5"				#4	18"	2 @ 4' - 5"	47	8 3/4"	90	.79	128.89	.882
	4	40	24	10"	8"	5' - 9"	11' - 4"	#7	8 1/2"	11' - 0"	#5	9"	12' - 5"				#4	18"	2 @ 5' - 5"	47	8 3/4"	90	.79	134.25	.931
	5	50	25	10"	8"	6' - 9"	11' - 4"	#7	8"	11' - 0"				#5	10"	7' - 5"	#4	18"	4 @ 4' - 0" *	51	8 3/4"	90	.79	145.78	.981
	6	60	26	10"	9"	7' - 9"	11' - 6"	#7	8 1/2"	11' - 2"				#5	9"	7' - 11"	#4	18"	4 @ 4' - 6" *	51	8 3/4"	90	.80	150.58	1.078
	7	70	27	10"	9"	8' - 9"	11' - 6"	#7	8 1/2"	11' - 2"				#5	9 1/2"	8' - 5"	#4	18"	4 @ 5' - 0" *	55	8 3/4"	90	.80	154.43	1.133
	8	80	28	10"	9"	9' - 9"	11' - 6"	#7	8"	11' - 2"				#5	10"	8' - 11"	#4	18"	4 @ 5' - 6" *	59	8 3/4"	90	.80	162.32	1.189
	9	90	29	10"	9"	10' - 9"	11' - 6"	#7	8"	11' - 2"				#5	10"	9' - 5"	#4	15"	4 @ 6' - 0" *	59	8 3/4"	90	.80	167.86	1.244
	10	100	30	10"	9"	11' - 9"	11' - 6"	#7	8"	11' - 2"				#5	10"	9' - 11"	#4	9 1/2"	4 @ 6' - 6" *	63	8 3/4"	90	.80	182.15	1.300
12	120	31	10"	9"	13' - 9"	11' - 6"	#7	8"	11' - 2"				#5	10"	10' - 11"	#5	8 1/2"	4 @ 7' - 6" *	67	8 3/4"	90	.80	212.06	1.411	
12'	5	60	32	11"	9"	6' - 11"	13' - 6"	#8	10 1/2"	13' - 2"				#5	8 1/2"	8' - 0"	#4	18"	4 @ 4' - 1" *	54	9 1/4"	110	.94	170.78	1.235
	6	72	33	11"	9"	7' - 11"	13' - 6"	#8	10 1/2"	13' - 2"				#5	9"	8' - 6"	#4	18"	4 @ 4' - 7" *	54	9 1/4"	110	.94	171.86	1.290
	7	84	34	11"	9"	8' - 11"	13' - 6"	#8	10"	13' - 2"				#5	9 1/2"	9' - 0"	#4	18"	4 @ 5' - 1" *	58	9 1/4"	110	.94	179.57	1.346
	8	96	35	11"	9"	9' - 11"	13' - 6"	#8	10"	13' - 2"				#5	9 1/2"	9' - 6"	#4	18"	4 @ 5' - 7" *	62	9 1/4"	110	.94	185.78	1.401
	9	108	36	11"	9"	10' - 11"	13' - 6"	#8	10"	13' - 2"				#5	9 1/2"	10' - 0"	#4	12"	4 @ 6' - 1" *	66	9 1/4"	110	.94	197.39	1.457
	10	120	37	11"	10"	11' - 11"	13' - 8"	#8	10"	13' - 4"				#5	9"	10' - 6"	#4	12"	4 @ 6' - 7" *	66	9 1/4"	110	.94	205.54	1.586
	11	132	38	11"	10"	12' - 11"	13' - 8"	#8	10"	13' - 4"				#5	9"	11' - 0"	#4	11"	4 @ 7' - 1" *	70	9 1/4"	110	.95	214.05	1.648
	12	144	39	11"	10"	13' - 11"	13' - 8"	#8	10"	13' - 4"				#5	8 1/2"	11' - 6"	#5	11 1/2"	4 @ 7' - 7" *	70	9 1/4"	110	.95	232.96	1.709
14	168	40	11"	11"	15' - 11"	13' - 10"	#8	10 1/2"	13' - 6"				#6	10"	12' - 6"	#5	8 1/2"	4 @ 8' - 7" *	78	9 1/4"	110	.96	275.12	1.931	

NOTES:

ALL CONSTRUCTION AND MATERIALS SHALL BE IN ACCORDANCE WITH THE OKLAHOMA CITY STANDARD SPECIFICATIONS.

REINFORCING STEEL IN BOTTOM SLAB (FOOTING) SHALL BE SUPPORTED ON BAR CHAIRS. CHAIRS SHALL BE SUPPORTED ON TIMBER PLANK OR CLASS "C" CONCRETE STRIPS PLACED AT 4" CENTERS.

REINFORCING STEEL IN TOP SLAB SHALL BE SUPPORTED ON SLAB SPACERS.

REINFORCING STEEL IN THE WALLS SHALL BE HELD IN PLACE BY METAL CHAIRS. MAXIMUM SPACING OF THE CHAIRS SHALL BE 6'.

COST OF METAL CHAIRS, WOOD PLANK OR CONCRETE STRIPS SHALL BE INCLUDED IN OTHER ITEMS OF WORK.

OKLAHOMA CITY
PUBLIC WORKS DEPARTMENT
ENGINEERING DIVISION

STANDARD RFCB - 1C - B

APPROVED BY: PAUL HARUM, P.E. CITY ENGINEER	DATE: 7-11-07	DRAWN: V.S.C.	DATE: 04/21/01	DWG. NO. D-301
---	---------------	------------------	-------------------	-------------------